190 Twin Lakes

PIN# 4736-62-2372

# L COUNTY HEALTH DEPARTMENT

STATESVILLE 704-878-5305 MOORESVILLE 704-664-5281

## OVEMENT PERMIT / CERTIFICATE OF COMPLETION / OPERATION PERMIT / EXISTING SYSTEM INSPECTION

TY DESCRIPTION NO. 25657 DATE 12-12-96 TAX MAP NO. 10D-2-A-37 Watershed: ☐ Yes ☑ No

ER OR CONTRACTOR Edwart Lintenberger PHONE: Business 872-0941 Home

DRESS 1966 woodlane ct. Asheboro N.C.

LOCATION 115 N TR S chipley Ford TR Twin Lakes at ent

SUBDIVISION Et Dobbs Fm BLOCK / SECTION LOT 37 LOT AREA 5.690 acres SITE CLASS. PS DESIGN FLOW 480 L.T.A.R. .33

Septic Tank: 1000 Gallons; STB 1012 Date 8/19/97

Pump Tank: Gallons; PT Date

Pump Make: Model Serial No.

Nitrification Field: No Fields 1 Square Feet 1500 Linear Feet 500

No Lines 5 Trench Width 36" Max Trench Bottom Depth 36" Gravel Depth 12"

☑ New System ☐ Repair System Type: I, II, III, IV, V, VI

System Description: Gravity Conv.

Repair System Description: 11 Chambers

Maintenance Agreement Required: ☐ Yes ☐ No

☑ House/Mod. Home No. Bedrooms 4

☐ Mobile Home No. Bathrooms 3

☐ Business No. Employees

☐ Other

☐ Slab ☐ Crawl Space ☑ Basement w/plumbing ☐ Basement wo/plumbing


Water Supply:
☐ Individual
☐ Community
☑ Public

Comments:


Comments:

700' +

### INITIAL SITE SKETCH

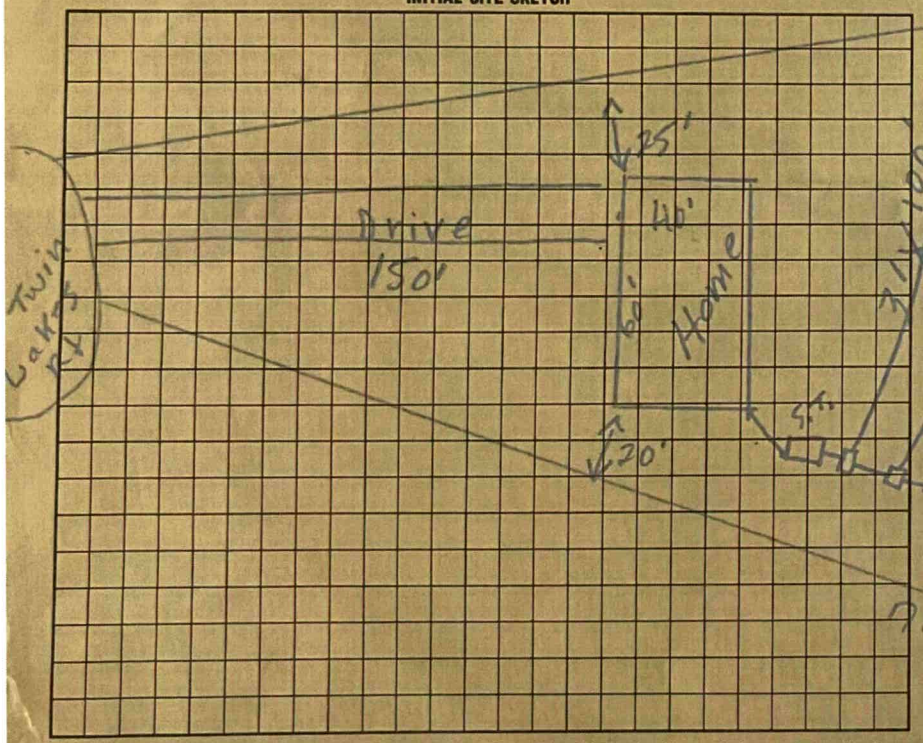


### AS BUILT SKETCH

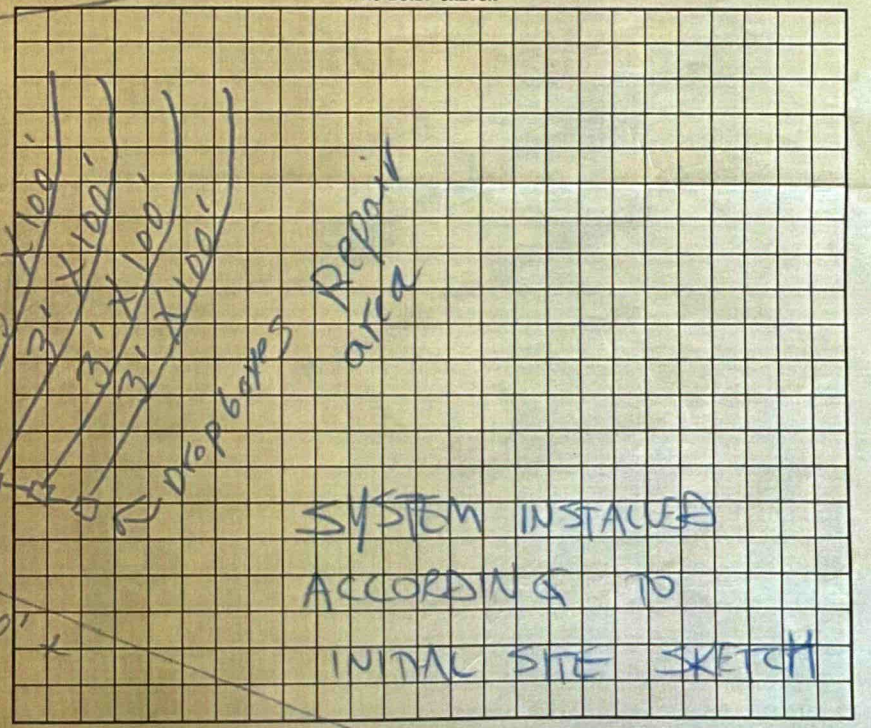


I understand that this permit can be suspended or revoked if any false information is supplied toward securing the permit/any unauthorized changes are made to the site/any unauthorized changes are made in the installation of the system. Improvement Permit is valid for 60 months from date of issuance.

Signed: 12-12-96

Improvement Permit by: P.C. Moore date 12-12-96

Existing System Inspection by: P.C. Moore date 12-12-96

Installed by: STEVE JORDAN

Certificate of Completion by: date

Operation Permit by: STEVE HEDRICK date 11-10-97

Authorization to Const.

authorization to Const. expires 2 years from issue

HEALTH DEPT. COPY: WHITE INSPECTION COPY (FINAL): GREEN OWNER COPY (FINAL): YELLOW INSPECTION COPY (INITIAL): PINK OWNER COPY (INITIAL): GOLD