ICHD - ENVIRONMENTAL HEALTH DIVISION

Statesville Office (704) 878-5305 x3456 | Mooresville Office (704) 660-3625

BM

PERMIT : OSWP - 2024-61703

SEPTIC: IMPROVEMENT PERMIT / AUTHORIZATION TO CONSTRUCT / OPERATION PERMIT / EXISTING SYSTEM

PIN # 4736-64-0726

APPLICANT/OWNER: BRENDA MAY | APPLICANT ADDRESS: 138 JENKINS ROAD, STATESVILLE, N.C 28625

SITE ADDRESS: 138 JENKINS ROAD, STATESVILLE, N.C. 28625 | PHONE: 704-450-8000 | ALT. PHONE —

SITE DIRECTIONS: (N) ON 115, (R) ON SOUTH CHIPLEY FORD, (R) ON CLEARVIEW, (L) ON JENKINS, LOT ON (R) | SAP CONTROLLED: ☐ YES ☐ NO → EXT

SUBDIVISION: CLEAR VIEW ACRES WOOTEN BROS ADD | SECTION: — | LOT # 13-15 | LOT AREA: 1.52AC | DESIGN FLOW: EXT | L.T.A.R.(Initial): EXT | L.T.A.R (Repair): EXT

Septic Tank	1000 (gal)	STB	2172	Date	INFILTRATOR	☐ New System	☑ Repair	☐ Expansion	System Type: I (II) III IV V VI
Pump Tank	— (gal)	PT	—	Date	—	System Description:	EXISTING CONVENTIONAL		
Pump Make	—	Model	—	Serial #	—	Repair System Description:	TANK REPLACEMENT		
# Nitrification Fields	EXT	# Lines	EXT	Linear Ft	EXT	Maintenance Agreement Required:	☐ YES	☑ NO	
Trench Width	EXT	*Max. Trench Depth(Initial)	EXT	*Max. Trench Depth(Repair)	EXT	Gravel Depth	EXT	☑ GRAVITY	☐ PRESSURE


* Measured on the downhill side of the trench | Effluent Standard: ☑ DSE ☐ HSE ☐ TS-I ☐ TS-II ☐ RCW ☐ NSF/ANSI 40 | Usable Depth to LC (Initial): EXT | Usable Depth to LC (Repair): EXT

☑ Residence	No. Bedrooms	EXT	**Water Supply**
☐ Business	No. Persons	EXT	☐ Private
☐ Other	No. Employees	—	☑ Public
☐ Slab	☐ Crawl Space		☐ Community
☑ Basement w/plumbing		☐ Basement w/o plumbing	

Limiting Condition

Comments / Conditions: PUMP, CRUSH, AND FILL EXISTING SEPTIC TANK, INSPECT AND REPLACE DISTRIBUTION DEVICES AS NEEDED, DRAINFIELD FUNCTIONING AT TIME OF INSPECTION

INITIAL SITE SKETCH

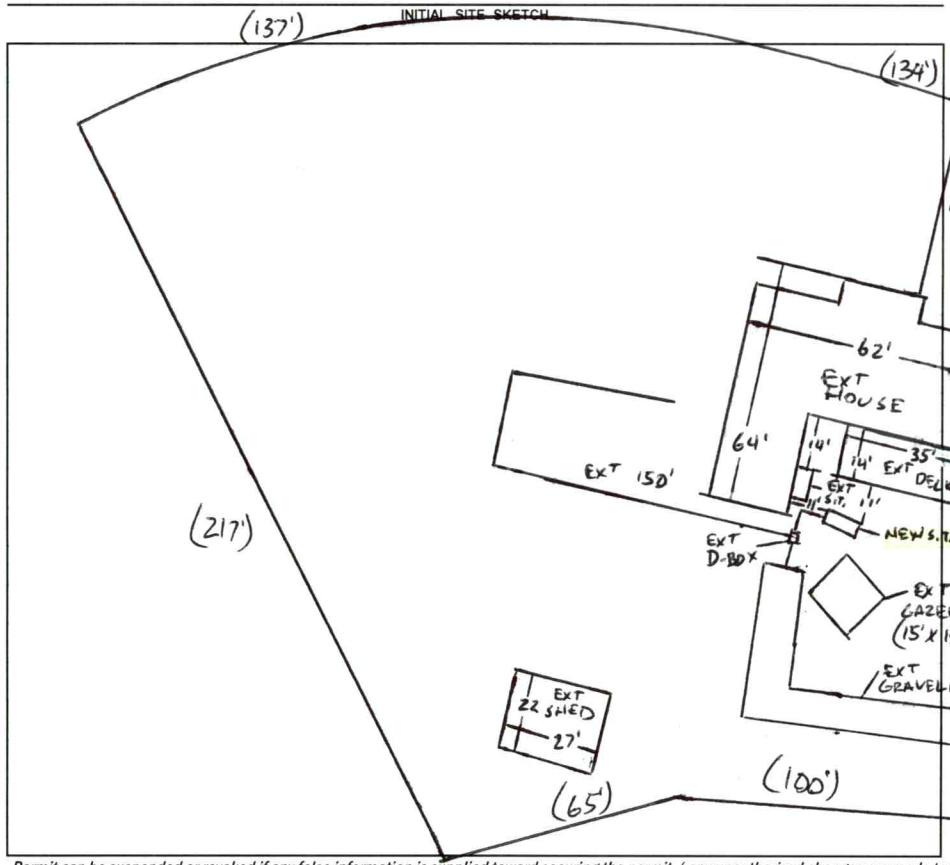

AS BUILT SKETCH

FOR SEPTIC FINAL INSPECTION CALL: 704-664-3703 between 8am-9am the day the inspection is needed. Be sure to speak with an inspector to confirm your time.

1 IN = 50 FT
S.T. = SEPTIC TANK
EXT = EXISTING

Permit can be suspended or revoked if any false information is supplied toward securing the permit / any unauthorized changes are made to the site / any unauthorized changes are made in the installation of the system. **CONTACT A LOCATOR SERVICE PRIOR TO ANY EXCAVATION**

☐ **IMPROVEMENT PERMIT** ***with plat*** *valid without expiration.* ☑ **IMPROVEMENT PERMIT** ***with site plan*** *valid for 60 mos.* ☑ **AUTHORIZATION TO CONSTRUCT** *valid for period equal to IMPROVEMENT PERMIT--not to exceed 60 mo.*

Owner / Applicant Signature: ONLINE SIGNATURE | Date: — | Installed by: RYAN BYERS

IMPROVEMENT PERMIT by: Burpee C. White | Date: 9-18-2024 | OPERATION PERMIT by: Burpee C. White | Date: 9-19-2024

AUTHORIZATION TO CONSTRUCT by: Burpee C. White | Date: 9-18-2024 | Existing System Inspected by: | Date:

Item	Date	Initials
Drain Lines Checked		
Tanks Checked		
Pressure Manifold or Valve Box Checked		
Pressure Head Set		
Electrical Checked		
Floats Set		
Alarm Checked		
Maintenance Contract Needed? Y / N		
Comments:		

Repairs Only	
	State Code
Failing System Code	
Type of Distribution	G or P
Type of Failure/Malfunction	
Primary Cause of Failure/Malfunction	
Age of System? _____	
Initial or Repair? _____	

PERMIT SNAPSHOT REPORT OSWP-2024-61703 FOR IREDELL COUNTY

Permit Type	Environmental Health OSWP	**Project:**		**App Date:**	09/12/2024
Work Class:	EH Septic Permit	**District:**	Iredell County	**Exp Date:**	NOT AVAILABLE
Status:	PRIORITY PERMIT	**Square Feet:**	0.00	**Completed:**	NOT COMPLETED
Valuation:	$0.00	**Assigned To:**	White, Bryant	**Approval Expire Date:**	
Description:	PRIORITY PERMIT -- REPAIR septic tank damaged				

Parcel: 4736640725.000 Main	**Address:** 138 Jenkins Rd Main Statesville, NC 28625	**Zone:** R-20(Suburban Residential District)

Property Owner	Applicant/Authorized Agent
Brenda May	Brenda May
138 Jenkins Road	138 Jenkins Road
Statesville, NC 28625	Statesville, NC 28625
Mobile: (704) 450-8000	Mobile: (704) 450-8000

Permit Custom Fields

How is your site plan being submitted	Custom Site Plan	Septic Application/Permit Type	Repair	Does the site contain any jurisdictional wetlands	No
Non-domestic Sewage Generated	No	Other Public Agency	No	All proposed structure dimensions	NA
Maximum Number of Bedrooms	3	If other Addition/Structure, please explain		Number of Occupants	6
Foundation Type	Basement with Plumbing	Water Supply	Community Well	Desired Septic System Type	Conventional (most common)
If other septic system type, please explain		Pump Make		# of Nitrification Fields	
Model		Serial #		System Description	
Repair System Description		Comments/Conditions		Additional Unique Setbacks Apply	No

Attachment File Name	Added On	Added By	Attachment Group	Notes
Signature_Brenda_May_9/12/2024.jpg	09/12/2024 11:46	May, Brenda		Uploaded via CSS
138 AA form_v1.pdf	09/12/2024 11:54	May, Brenda	Available Online	
138 site plan_v1.pdf	09/12/2024 11:54	May, Brenda	Available Online	

Invoice No.	Fee	Fee Amount	Amount Paid
INV-00035871	Existing System Septic Repair Permit	$150.00	$150.00
	Total for Invoice INV-00035871	$150.00	$150.00
	Grand Total for Permit	**$150.00**	**$150.00**

Workflow Step / Action Name	Action Type	Start Date	End Date
Application Completeness Check v.1		09/12/2024 11:57	09/12/2024 11:57
Confirm application complete v.1	Generic Action		09/12/2024 11:57
~~**Zoning Review v.1**~~			09/12/2024 11:58
~~Floodplain Admin Overview v.1~~	Task		09/12/2024 11:58
~~Iredell County Zoning Approval v.1~~	Task		09/12/2024 11:58
~~Issue Invoice v.1~~	Generic Action		09/12/2024 11:58
~~Fees Paid v.1~~	Generic Action		09/12/2024 11:58
Fees v.1		09/12/2024 11:58	09/12/2024 12:07
Issue Invoice v.1	Generic Action		09/12/2024 11:59
Fees Paid v.1	Generic Action		09/12/2024 12:07