IREDELL COUNTY HEALTH DEPARTMENT

Statesville Office (704) 878-5305 Mooresville Office (704) 660-3625 PERMIT # 20/233

IMPROVEMENT PERMIT / AUTHORIZATION TO CONSTRUCT / OPERATION PERMIT / EXISTING SYSTEM

PIN # 4736642677

APPLICANT: Travis Brown APPLICANT ADDRESS: 154 Jenkins Rd Statesville NC 28625

SITE ADDRESS: 154 Jenkins Rd Statesville NC 28625 PHONE: 704-876-4283 ALT. PHONE: 704-928-9171

SITE DIRECTIONS: 115 N to S. Chipley Ford Rd (R) on Clearview (L) on Jenkins Rd


SUBDIVISION: Clearview SECTION: N/A LOT # 16 LOT AREA: .53 ac DESIGN FLOW: 240 L.T.A.R.: .3

Septic Tank	Existing (gal)	STB	EX	Date	EX	☐ New System	☒ Repair	☐ Expansion	System Type: I (II) III IV V VI	☒ Residence	No. Bedrooms 2
Pump Tank	N/A (gal)	PT	N/A	Date	N/A	System Description:	N/A			☐ Business	No. Persons 4
Pump Make	N/A	Model	N/A	Serial #	N/A	Repair System Description:	25% Reduction			☐ Other	No. Employees
# Nitrification Fields	1	# Lines	4	Linear Ft:	226'	Maintenance Agreement Required:	☐ YES	☒ NO		☐ Slab	☐ Crawl Space
Trench Width	36"	Max. Trench Bottom Depth	36"	Gravel Depth	N/A	☒ GRAVITY	☐ PRESSURE			☐ Basement w/plumbing	☒ Basement w/o plumbing

Water Supply: ☐ Private ☒ Public ☐ Community

Comments / Conditions: Check tank, Check tee, replace if necessary. Install 25% reduction with serial distribution on Contour.

INITIAL SITE SKETCH

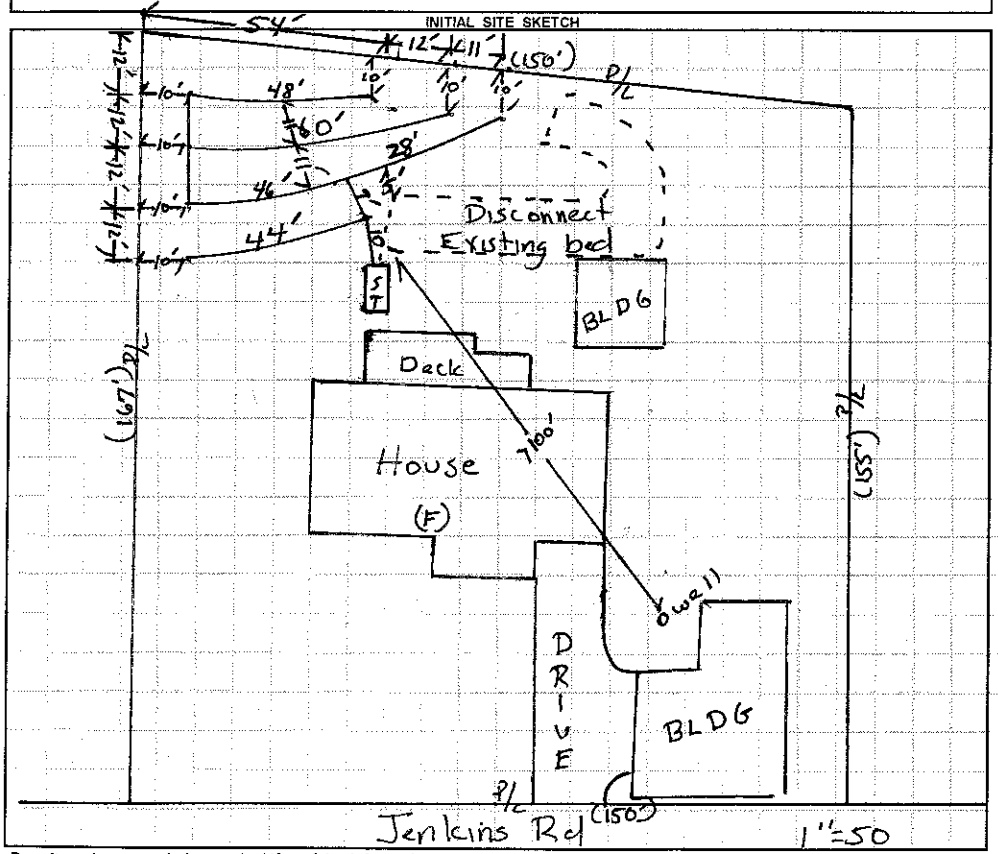

AS BUILT SKETCH

Infiltrator Quick 4 installed as designed 02/24/14

Permit can be suspended or revoked if any false information is supplied toward securing the permit / any unauthorized changes are made to the site / any unauthorized changes are made in the installation of the system. **CONTACT A LOCATOR SERVICE PRIOR TO ANY EXCAVATION**

☐ **IMPROVEMENT PERMIT** *with plat valid without expiration.* ☒ **IMPROVEMENT PERMIT** *with site plan valid for 60 mos.* ☒ **AUTHORIZATION TO CONSTRUCT** *valid for period equal to IMPROVEMENT PERMIT--not to exceed 60 mo.*

Owner / Applicant Signature: Travis Brown Date: 2/7/14 Installed by: K & M Grading

IMPROVEMENT PERMIT by: Robert H. Shaw Date: 02/06/14 OPERATION PERMIT by: Robert H. Shaw Date: 2/24/14

AUTHORIZATION TO CONSTRUCT by: Robert H. Shaw Date: 02/06/14 Existing System Inspected by: Date:

Health Dept. Copy - WHITE Applicant (Final Approval) - YELLOW Applicant (Conditional Approval) - PINK