IREDELL COUNTY HEALTH DEPARTMENT

STATESVILLE 704-878-5305 MOORESVILLE 704-664-5281

IMPROVEMENT PERMIT / CERTIFICATE OF COMPLETION / OPERATION PERMIT / EXISTING SYSTEM INSPECTION

PROPERTY DESCRIPTION NO. REPAIR DATE 11-24-97 TAX MAP NO. REPAIR Watershed: ☐ Yes ☑ No

OWNER OR CONTRACTOR MARGARET A. DAVIS PHONE: Business Home 876-6888

ADDRESS 135 JENKINS ROAD, STATESVILLE NC 28625

LOCATION NC 115 N, TR S. CHIPLEY FORD, TR CLEARVIEW, TL JENKINS, 3RD ON LEFT AT # 135

SUBDIVISION CLEARVIEW ACRES BLOCK / SECTION LOT LOT AREA SITE CLASS. PS DESIGN FLOW 480 L.T.A.R. EXISTING

Septic Tank: 1000 Gallons; STB 1012 Date 8/29/97

Pump Tank: Gallons; PT Date

Pump Make: Model Serial No.

Nitrification Field: No Fields Square Feet Linear Feet EXISTING

No Lines Trench Width Max Trench Bottom Depth Gravel Depth

☐ New System ☑ Repair System Type: I, II, III, IV, V, VI

System Description: CONV. GRAVITY

Repair System Description: CONV. GRAVITY

Maintenance Agreement Required: ☐ Yes ☑ No

☑ House/Mod. Home No. Bedrooms 4

☐ Mobile Home No. Bathrooms 4

☐ Business No. Employees

☐ Other


☐ Slab ☐ Crawl Space ☑ Basement w/plumbing ☐ Basement wo/plumbing

Water Supply: ☑ Individual ☐ Community ☐ Public WELL


Comments: NEW S.T. SET WHERE OLD TANK CRUSHED
NEW D. BOX SET

Comments:

INITIAL SITE SKETCH

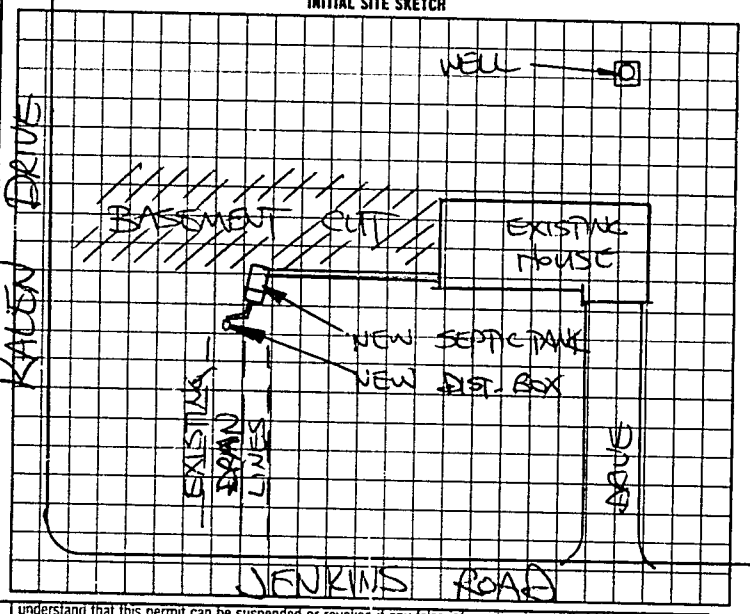

AS BUILT SKETCH

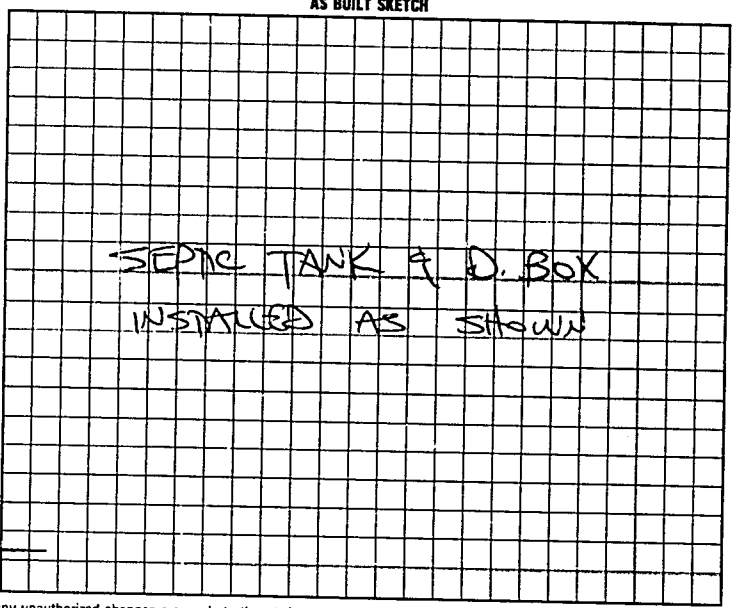

I understand that this permit can be suspended or revoked if any false information is supplied toward securing the permit/any unauthorized changes are made to the site/any unauthorized changes are made in the installation of the system. Improvement Permit is valid for 60 months from date of issuance. AUTHORIZATION TO CONSTRUCT IS VALID FOR 60 MONTHS FROM DATE OF ISSUANCE

Signed: Margaret Davis

Improvement Permit by: STEVE HEDRICK date 11-24-97

AUTH. TO CONST.

Existing System Inspection by: STEVE HEDRICK date 11-24-97

Installed by: FORREST STAFFORD

Certificate of Completion by: date

Operation Permit by: STEVE HEDRICK date 11-24-97

HEALTH DEPT. COPY WHITE INSPECTION COPY (FINAL) GREEN OWNER COPY (FINAL) YELLOW INSPECTION COPY (INITIAL) PINK OWNER COPY (INITIAL) GOLD