IREDELL COUNTY HEALTH DEPARTMENT

Statesville Phone TR 3-7271 Mooresville Phone NO 3-1271

PERMIT TO INSTALL SEPTIC TANK

Permit No. 132 Permit Date 9-11 1972

Owner Herman Hammer (Bobby Combs Builder) Address Statesville N.C.

Installed By Harlee Lackey Address Stony Point N C

Location of Property Clear View Acres -


Out Chipley Ford Rd - T.R. on Dead end Rd # 1964 in Clear view - House at end of Road

Tank		Capacity		Length of Lines		Fixtures	
Block	( )	1000	(✓)	225'	(✓)	No. of Baths	(1½)
Precast	(✓)	1250	( )	250'	( )	Dishwasher	( )
		1500	( )	Other		Garbage Grdr.	( )
		Other				Other	

NOTIFY HEALTH DEPARTMENT AT LEAST EIGHT HOURS BEFORE TANK IS TO BE INSPECTED.

Final Inspection 9-11 1972 Approved (✓) Disapproved ( )

Remarks Community Water

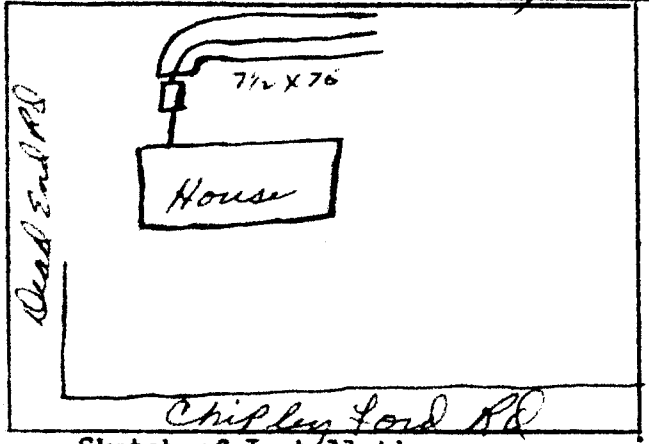

Sketch of Installation

Lines are keep up next to tank

E. A. Stevenson

Sanitarian