IREDELL COUNTY HEALTH DEPARTMENT

Statesville Office (704) 878-5305 Mooresville Office (704) 660-3625 PERMIT # 20001 1 BP

IMPROVEMENT PERMIT / AUTHORIZATION TO CONSTRUCT / OPERATION PERMIT / EXISTING SYSTEM

PIN # 4736654139

APPLICANT: Jeffery Phillips APPLICANT ADDRESS: 142 Vicwmont Ct.

SITE ADDRESS: 142 Vicwmont Ct. PHONE: 704-682-3930 ALT. PHONE: N/A


SITE DIRECTIONS: Hwy 115 N TR S Chipley Ford Rd TR Viewmont Ct.

SUBDIVISION: Clearview Acres SECTION: N/A LOT # 38 LOT AREA: 1.01 acres DESIGN FLOW: 360 gpd L.T.A.R.: Existing

Septic Tank	1000 (gal)	STB	760-1000	Date	8-7	☐ New System	☑ Repair	☐ Expansion	System Type: I III IV V VI	☑ Residence	No. Bedrooms 3	Water Supply
Pump Tank	(gal)	PT		Date		System Description:				☐ Business	No. Persons	☐ Private
Pump Make		Model		Serial #		Repair System Description:	TANK			☐ Other	No. Employees	☐ Public
# Nitrification Fields	Ex	# Lines	Ex	Linear Ft:	Ex	Maintenance Agreement Required:	☐ YES	☑ NO		☐ Slab	☐ Crawl Space	☑ Community
Trench Width	Ex	Max. Trench Bottom Depth	Ex	Gravel Depth	Ex		☑ GRAVITY	☐ PRESSURE		☑ Basement w/ plumbing	☐ Basement w/o plumbing	

Comments / Conditions: Install a new 1000 gallon septic tank @ location shown below & connect to existing drainfield. Install riser over septic tank if tank is deeper than 6" below grade.

INITIAL SITE SKETCH

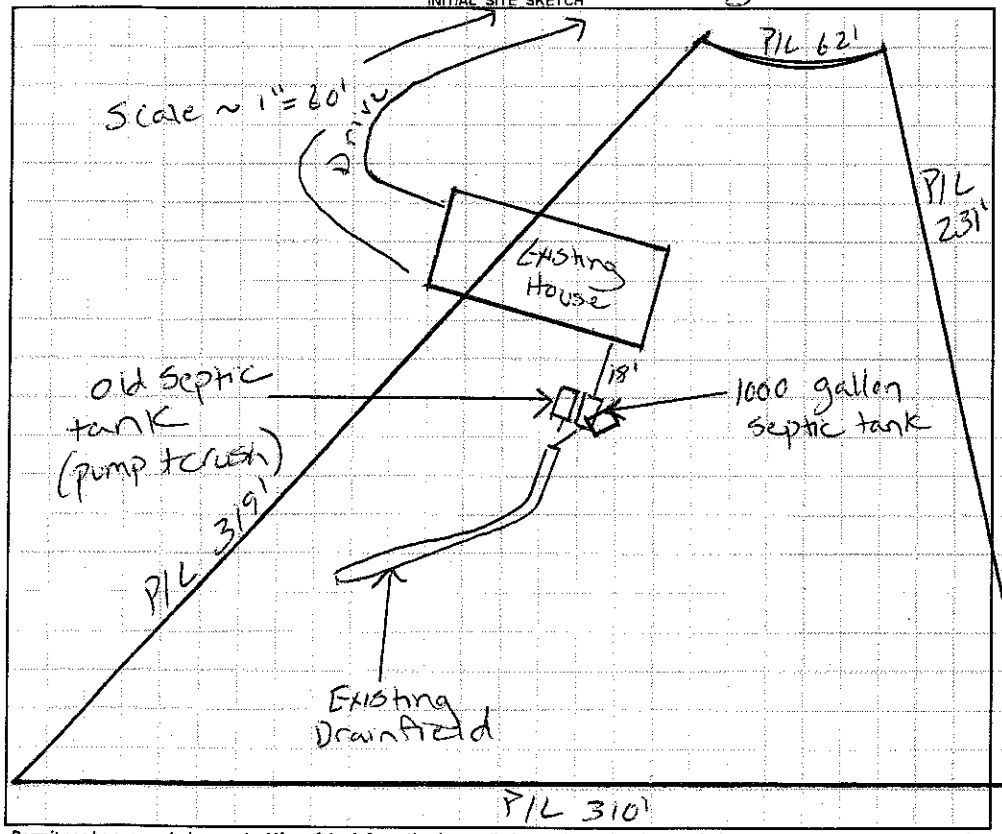

AS BUILT SKETCH

Septic tank installed w/risers @ location shown

-Red Polylok filter installed

Permit can be suspended or revoked if any false information is supplied toward securing the permit / any unauthorized changes are made to the site / any unauthorized changes are made in the installation of the system. **CONTACT A LOCATOR SERVICE PRIOR TO ANY EXCAVATION**

☐ **IMPROVEMENT PERMIT** *with plat valid without expiration.* ☑ **IMPROVEMENT PERMIT** *with site plan valid for 60 mos.* ☑ **AUTHORIZATION TO CONSTRUCT** *valid for period equal to IMPROVEMENT PERMIT--not to exceed 60 mo.*

Owner / Applicant Signature: Joyce Phillips Date: Installed by: Jared Lentz

IMPROVEMENT PERMIT by: Justin Henderson Date: 11-20-13 OPERATION PERMIT by: Justin Henderson Date: 11-22-13

AUTHORIZATION TO CONSTRUCT by: Justin Henderson Date: 11-20-13 Existing System Inspected by: Date:

Health Dept. Copy - WHITE Applicant (Final Approval) - YELLOW Applicant (Conditional Approval) - PINK