IREDELL COUNTY HEALTH DEPARTMENT

Statesville Office (704) 878-5305 Mooresville Office (704) 660-3625 PERMIT # 21711

IMPROVEMENT PERMIT / AUTHORIZATION TO CONSTRUCT / OPERATION PERMIT / EXISTING SYSTEM

PIN # 4736671766

APPLICANT: Mark Surgen APPLICANT ADDRESS: 2541 S Chipley Ford Rd.

SITE ADDRESS: 2541 S Chipley Ford Rd. PHONE: 802-249-1702 ALT. PHONE: N/A

SITE DIRECTIONS: Hwy 115N TR S Chipley Ford Rd. Property on left just past Nixon Rd.

SUBDIVISION: Chipley Park SECTION: 2 LOT # 152-159 LOT AREA: 0.94 acres DESIGN FLOW: Existing L.T.A.R.: Existing

Septic Tank	Existing (gal)	STB	Date	☐ New System ☐ Repair ☐ Expansion System Type: I II III IV V VI	☑ Residence	No. Bedrooms	Ex	Water Supply	
Pump Tank	(gal)	PT	Date	System Description: Existing	☐ Business	No. Persons	Ex	☐ Private	
Pump Make	Model		Serial #	Repair System Description:	☐ Other	No. Employees		☑ Public	
# Nitrification Fields	Ex # Lines	Ex	Linear Ft: Ex	Maintenance Agreement Required: ☐ YES ☑ NO	☐ Slab	☑ Crawl Space		☐ Community	
Trench Width	Ex Max. Trench Bottom Depth	Ex	Gravel Depth Ex	☑ GRAVITY ☐ PRESSURE	☐ Basement w/plumbing			☐ Basement w/o plumbing	


Comments / Conditions:

- Maintain a minimum of 5' between proposed storage building & all components of septic tank system.

INITIAL SITE SKETCH

P/L 200'

AS-BUILT SKETCH

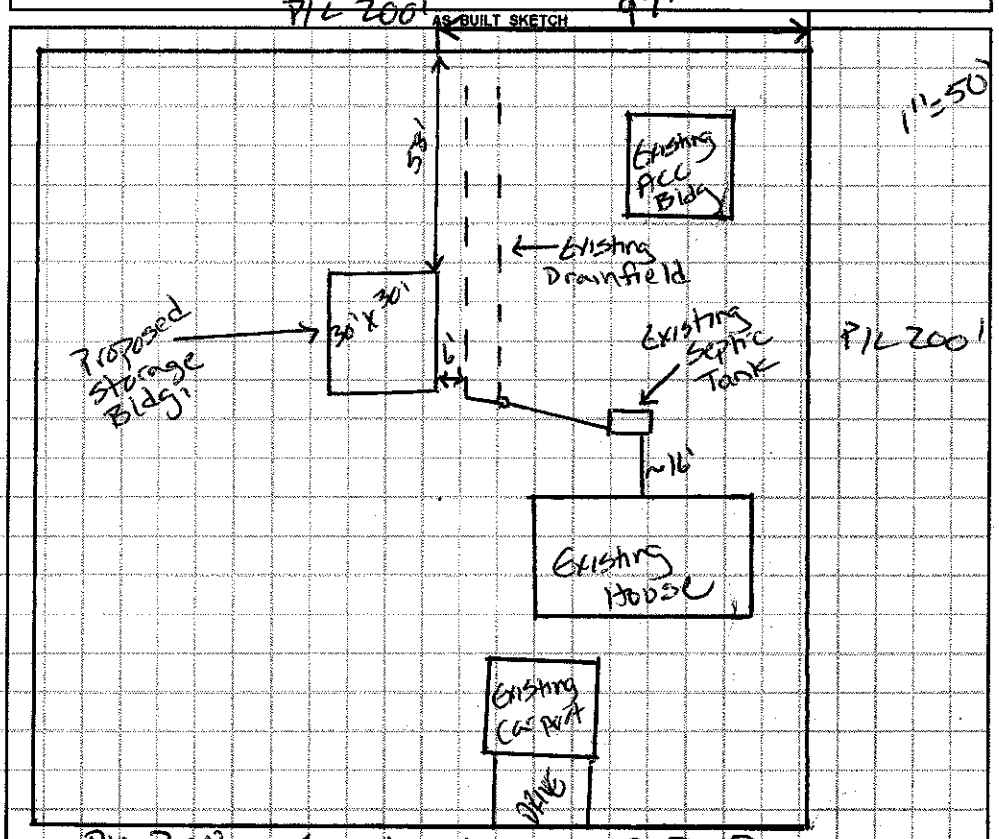

Permit can be suspended or revoked if any false information is supplied toward securing the permit / any unauthorized changes are made to the site / any unauthorized changes are made in the installation of the system. CONTACT A LOCATOR SERVICE PRIOR TO ANY EXCAVATION

☐ IMPROVEMENT PERMIT with plat valid without expiration. ☐ IMPROVEMENT PERMIT with site plan valid for 60 mos. ☐ AUTHORIZATION TO CONSTRUCT valid for period equal to IMPROVEMENT PERMIT--not to exceed 60 mo.

Owner / Applicant Signature: Date: 4/2/16 Installed by:

IMPROVEMENT PERMIT by: Date: OPERATION PERMIT by: Date:

AUTHORIZATION TO CONSTRUCT by: Date: Existing System Inspected by: Justin Henderson Date: 4-2-16

Health Dept. Copy - WHITE Applicant (Final Approval) - YELLOW Applicant (Conditional Approval) - PINK