ICHD - ENVIRONMENTAL HEALTH DIVISION

Statesville Office (704) 878-5305 Mooresville Office (704) 660-3625

PERMIT # OSWP-2024-44707

SEPTIC: IMPROVEMENT PERMIT / AUTHORIZATION TO CONSTRUCT / OPERATION PERMIT / EXISTING SYSTEM

Repair PIN # 4736-67-4722

APPLICANT / OWNER: tammy redmond | APPLICANT ADDRESS: 2536 south chipley ford rd, statesville, NC 28625

SITE ADDRESS: 2536 S CHIPLEY FORD RD, STATESVILLE, NC 28625 | PHONE: – | ALT. PHONE: –

SITE DIRECTIONS: Hwy 115 to S Chipley Site on Right | SAP CONTROLLED: YES ☐ NO ☑


SUBDIVISION: Chipley Park | SECTION: – | LOT #: 132-135 | LOT AREA: 100 x 200 | DESIGN FLOW: 360 | L.T.A.R.: Ext

Septic Tank: (gal) 1000	STB: Infiltrator	Date:	☐ New System ☑ Repair ☐ Expansion	System Type: II	☑ Residence	No. Bedrooms: 3
Pump Tank: (gal) –	PT: –	Date: –	System Description:		☐ Business	No. Persons: 6
Pump Make: –	Model: –	Serial #: –	Repair System Description: Tank Replacement		☐ Other	No. Employees:
Nitrification Fields: Ext	# Lines: Ext	Linear Ft.: Ext	Maintenance Agreement Required: ☐ YES ☑ NO		☐ Slab	☑ Crawl Space
Trench Width: Ext	Trench Bottom Depth (Low side): Ext		Gravel Depth: Ext	☑ GRAVITY ☐ PRESSURE	☐ Basement w/ Plumbing	☐ Basement w/o Plumbing


Water Supply: Community Well

Comments / Conditions: Pump / Crush / Fill old tank - Install 1000 gallon Tank Inspect & Replace D-Box if needed.

INITIAL SITE SKETCH

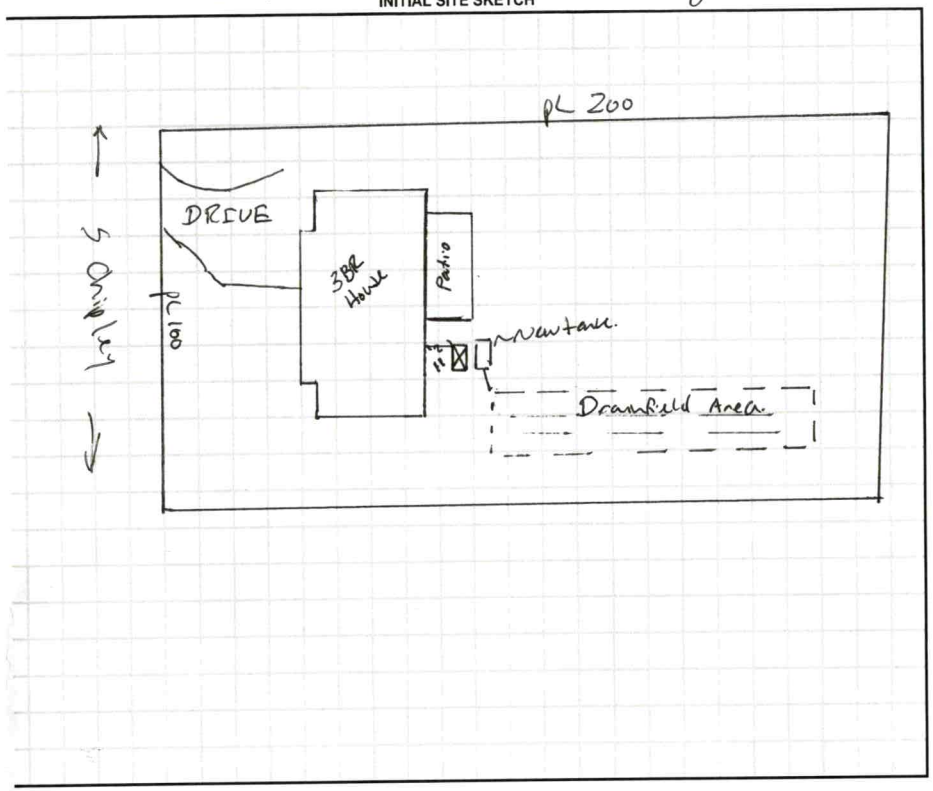

AS BUILT SKETCH

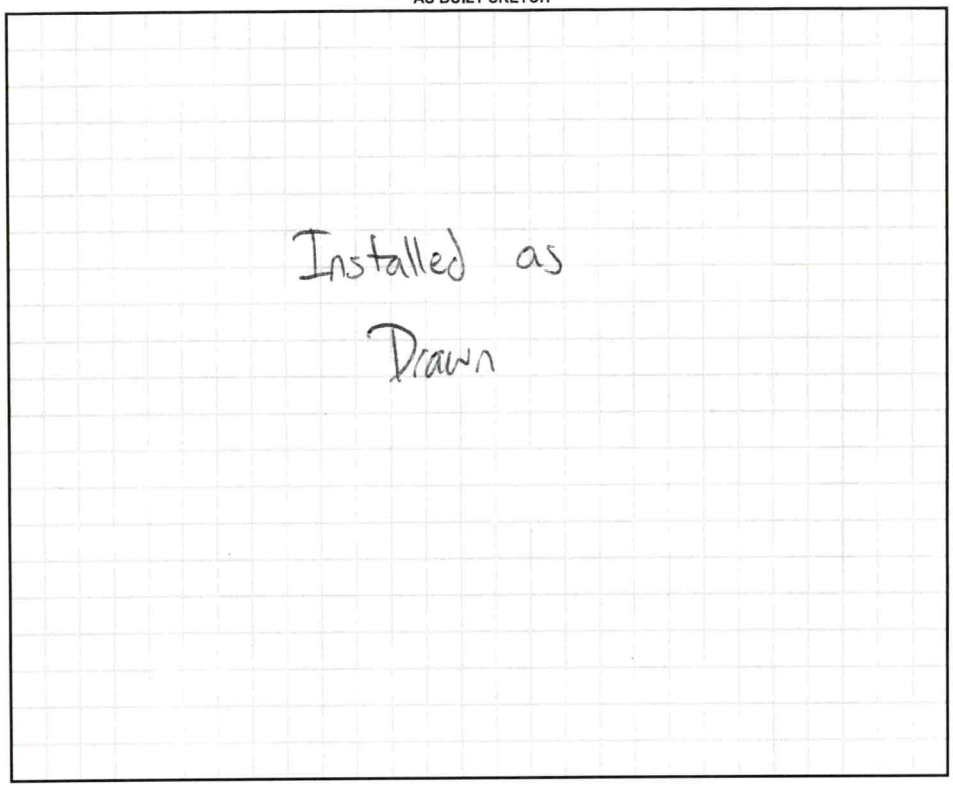

Permit can be suspended or revoked if any false information is supplied toward securing the permit / any unauthorized changes are made to the site / any unauthorized changes are made in the installation of the system. CONTACT A LOCATOR SERVICE PRIOR TO ANY EXCAVATION

☐ IMPROVEMENT PERMIT with plat valid without expiration. ☑ IMPROVEMENT PERMIT with site plan valid for 60 mos. ☑ AUTHORIZATION TO CONSTRUCT valid for period equal to IMPROVEMENT PERMIT--not to exceed 60 mo.

Owner / Applicant Signature: _____ Date: _____ Installed By: Lentz

IMPROVEMENT PERMIT by: Benjamin A. Baker Date: 1/18/2024 OPERATION PERMIT by: Tony Whitt Date: 1/30/24

AUTHORIZATION TO CONSTRUCT by: Benjamin A. Baker Date: 1/18/2024 Existing System Inspected By: _____ Date: _____

FOR SEPTIC FINAL INSPECTION CALL: 704-664-3703 BETWEEN 8am-9am the day the inspection is needed.