IREDELL COUNTY HEALTH DEPARTMENT

STATESVILLE 704-878-5305 MOORESVILLE 704-664-5281

IMPROVEMENT PERMIT / AUTHORIZATION TO CONSTRUCT / OPERATION PERMIT / EXISTING SYSTEM INSPECTION

PERMIT# 108256 PIN# 4936-67-5858 DATE 9/3/02

OWNER OR CONTRACTOR Statesville Housing Center PHONE: Business (704) 924-9393 Home —

ADDRESS 115 Morehead Road Statesville N.C. 28677

LOCATION 2nd ~~1st~~ 115 N ⓡ on Chipley Ford Rd ⓡ on Gravel Road across from Cross White Lane @ End of Drive

SUBDIVISION Chipley Park Place BLOCK / SECTION 1 LOT 120-123 LOT AREA .666 Ac. SITE CLASS 15 DESIGN FLOW 360 L.T.A.R. .40 spd/ft²

Septic Tank: 4,000 Gallons: STB 1012 Date 8-2-02

Pump Tank: — Gallons: PT — Date —

Pump Make: — Model — Serial No —

Nitrification Field: No Fields 1 Square Feet 900 Linear Feet 300

No Lines 4 @ 75 Trench Width 36" Max Trench Bottom Depth 36"

X New System ☐ Repair System Type: I (II) III IV V VI

System Description: Gravity, Conventional

Repair System Description: Gravity, 25% Red

Maintenance Agreement Required: ☐ Yes ☐ No

Gravel Depth 12" ☐ Slab X Crawl Space ☐ Basement w/plumbing ☐ Basement wo/plumbing

X House/Mod. Home No Bedrooms 3

☐ Mobile Home No. Bathrooms 2

☐ Business No Employees —

☐ Other —


Water Supply: ☐ Individual X Public ☐ Community

Comments/Conditions:

Comments/Conditions

- Poly Lok Filter Installed
- S. T. Marker Installed

INITIAL SITE SKETCH

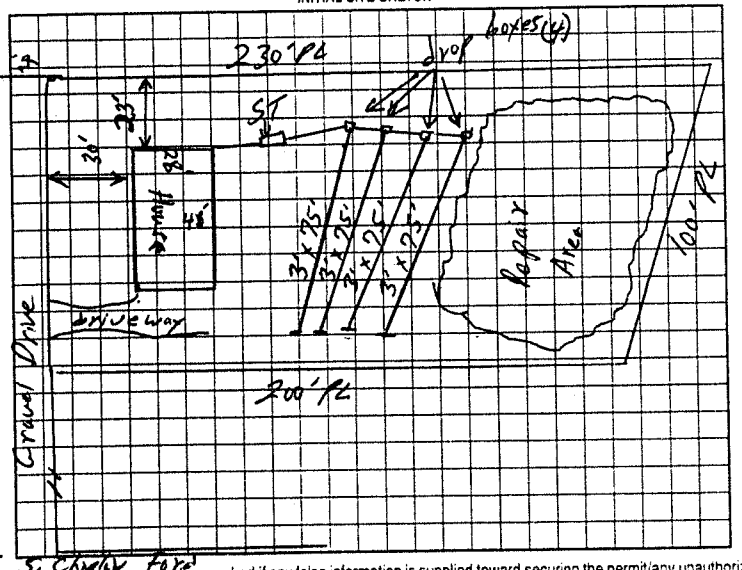

AS BUILT SKETCH

Installed as Shown Per Initial Site Sketch

Permit can be suspended or revoked if any false information is supplied toward securing the permit/any unauthorized changes are made to the site any unauthorized changes are made in the installation of the system. Improvement Permit with plat valid without expiration, Improvement Permit with site plan valid for sixty months. Authorization to Construct is valid for a period equal to that of Improvement Permit – not to exceed sixty months

Signed: Ken Walters date 9/3/02 Installed by: A-C Backhoe

Improvement Permit by: William O. Johnson date 9/3/02 Operation Permit by: William O. Johnson date 9/4/02

Authorization to Construct by: William O. Johnson date 9/3/02 Existing System Inspection by: — date —

HEALTH DEPT COPY WHITE OWNER COPY (FINAL) YELLOW OWNER COPY (INITIAL) PINK