IREDELL COUNTY HEALTH DEPARTMENT

STATESVILLE 704-878-5305 MOORESVILLE 704-664-5281

IMPROVEMENT PERMIT / AUTHORIZATION TO CONSTRUCT / OPERATION PERMIT / EXISTING SYSTEM INSPECTION

PERMIT# REPAIR PIN# 4736-67-6668 DATE 5-21-2007

OWNER OR APPLICANT PENTECOSTAL TABERNACLE PHONE: Business 704-872-2259 Home 704-500-7674

ADDRESS 115 NIXON ROAD STATESVILLE, NC 28625

LOCATION NC 115 N TR S. CHIPLEY FORD ROAD TR NIXON ROAD 3RD LOT ON LEFT

SUBDIVISION CHIPLEY PARK BLOCK / SECTION ____ LOT 144-147 116-119 LOT AREA LIMITED SITE CLASS PS DESIGN FLOW 750 L.T.A.R. EXISTING

HD

Septic Tank: 1500 Gallons; STB 379 Date 4-4-07

Pump Tank: ____ Gallons; PT ____ Date ____

Pump Make: ____ Model ____ Serial No. ____

Nitrification Field: No Fields ____ Square Feet ____ Linear Feet EXISTING

No Lines ____ Trench Width ____ Max Trench Bottom Depth ____ Gravel Depth N/A ☑ Gravity ☐ Pressure

☐ New System ☑ Repair ☐ Expansion System Type: I II III IV V VI

System Description: ____

Repair System Description: CONVENTIONAL GRAVITY

Maintenance Agreement Required: ☐ Yes ☑ No

☐ House/Mod. Home No. Bedrooms ____

☐ Mobile Home No. Persons ____

☐ Business No. Employees ____

☑ Other CHURCH W/250 @ 3GPD


Water Supply: ☐ Individual ☑ Public ☐ Community

☐ Slab ☐ Crawl Space ☐ Basement w/plumbing ☐ Basement wo/plumbing


Comments/Conditions: REPLACE EXISTING BLOCK TANK WITH NEW PRECAST 1500 GALLON "TRAFFIC RATED" SEPTIC TANK

Comments/Conditions: SYSTEM REPAIRED ACCORDING TO INITIAL SITE SKETCH

INITIAL SITE SKETCH

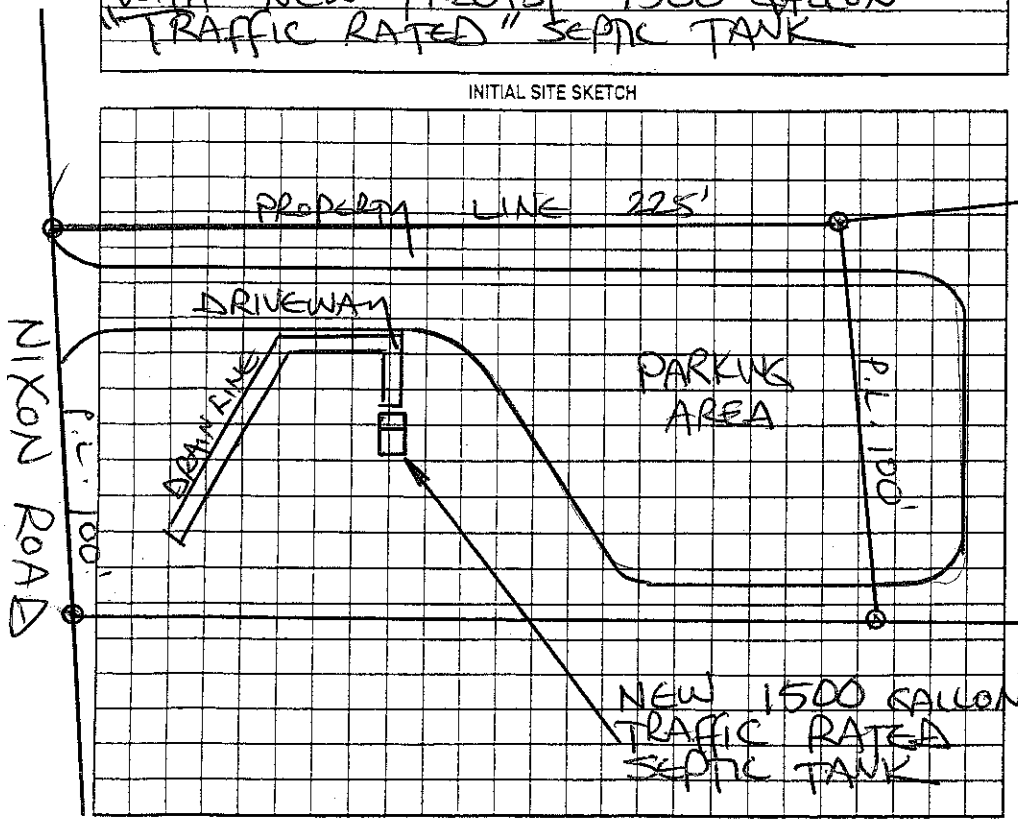

AS BUILT SKETCH

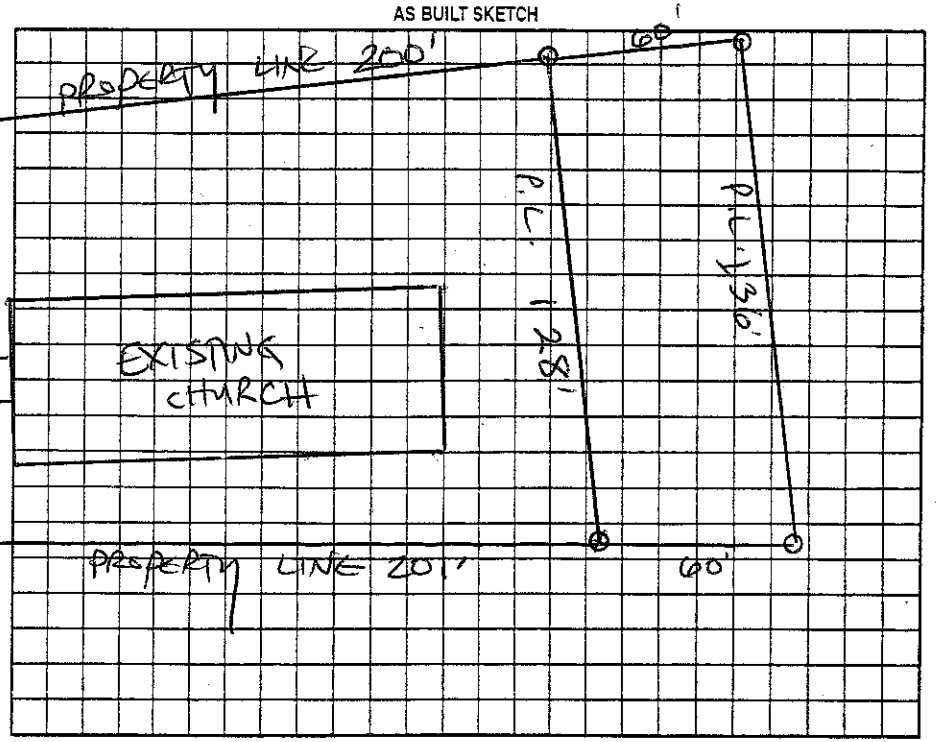

Permit can be suspended or revoked if any false information is supplied toward securing the permit/any unauthorized changes are made to the site/any unauthorized changes are made in the installation of the system. Improvement Permit with plat valid without expiration ☐ Improvement Permit with site plan valid for sixty months ☑ Authorization to Construct is valid for a period equal to that of Improvement Permit – not to exceed sixty months.

Signed: ____ date 5-23-07 Installed by: JAMES HUALER

Improvement Permit by: STEVE HEDRICK date 5-21-07 Operation Permit by: STEVE HEDRICK date 5-24-07

Authorization to Construct by: STEVE HEDRICK date 5-21-07 Existing System Inspection by: ____ date ____

HEALTH DEPT. COPY: WHITE OWNER COPY (FINAL): YELLOW OWNER COPY (INITIAL): PINK