IREDELL COUNTY HEALTH DEPARTMENT

Statesville Phone TR 3-7271 Mooresville Phone NO 3-1271

PERMIT TO INSTALL SEPTIC TANK

Permit No. 9 Permit Date _____ 19__

Owner Bobby Earl Davis Address R. 5 Statesville NC

Installed By Lee Lee Owen Address Rt 5 Box 4


Location of Property 115 N.R. on Cooley Rd. R. on Davis Rd. first building on left

Tank		Capacity		Length of Lines		Fixtures	
Block	(✓)	1000	(✓)	225'	(✓)	No. of Baths	(2)
Precast	( )	1250	( )	250'	( )	Dishwasher	( )
		1500	( )	Other 575 sq ft		Garbage Grdr.	( )
		Other _____				Other _____	

NOTIFY HEALTH DEPARTMENT AT LEAST EIGHT HOURS BEFORE TANK IS TO BE INSPECTED.

Final Inspection 2 7 1968 Approved (✓) Disapproved ( )

Remarks _____

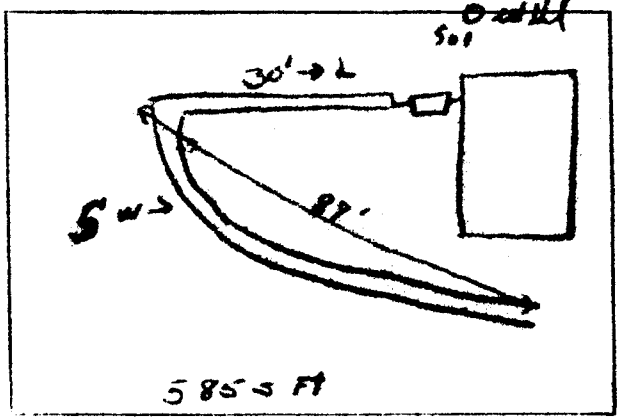

Sketch of Installation

Lee Owen Hutchins R.S.

Sanitarian