IREDELL COUNTY HEALTH DEPARTMENT

Statesville Phone TR 3-7271 Mooresville Phone NO 3-1271

PERMIT TO INSTALL SEPTIC TANK

Permit NO. 90 Gofourth Permit Date Mar 23 1964

Owner Gafourth Homes Inc. Address Chipley Park

Installed By C Hoke Address


Location of Property our Chipley Ford Rd 1st dirt to Right past colony acres 1st on R.

Tank		Capacity		Length of Lines		Fixtures	
Block	( )	800	( )	150'	( )	No. of Baths	(2)
Precast	(✓)	900	( )	175'	( )	Dishwasher	( )
		1000	(✓)	200'	( )	Garbage Grdr.	( )
		1100	( )	225'	(✓)	Auto-Washer	(✓)
		1200	( )	250'	( )	Other	
		Other		Other			

NOTIFY HEALTH DEPARTMENT AT LEAST EIGHT HOURS BEFORE TANK IS TO BE INSPECTED.

Final Inspection 3-23 1964 Approved (✓) Disapproved ( )

Remarks well not down this date

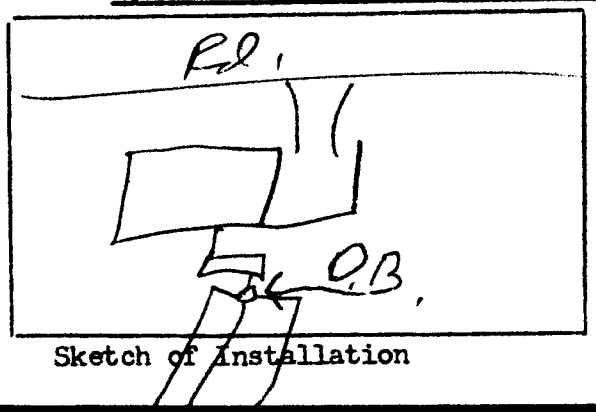

Sketch of Installation

Sanitarian