IREDELL COUNTY HEALTH DEPARTMENT

Statesville Office (704) 878-5305 Mooresville Office (704) 660-3625 PERMIT # 229502

SEPTIC IMPROVEMENT PERMIT / AUTHORIZATION TO CONSTRUCT / OPERATION PERMIT / EXISTING SYSTEM

PIN # 4736691351

APPLICANT/OWNER: Lorene Wallace APPLICANT ADDRESS: 2610 S Chipley Ford RD Statesville NC 28625

SITE ADDRESS: 2610 S. Chipley Ford RD Statesville NC 28625 PHONE: — ALT. PHONE —

SITE DIRECTIONS: Hwy 21 to Shumaker To Nixon Right on S. Chipley Rd lot on Right SAP CONTROLLED: ☐ YES ☒ NO


SUBDIVISION: Chipley Park SECTION: M1 LOT # 4-7 LOT AREA: — DESIGN FLOW: 240 L.T.A.R.: EXT

Septic Tank	1000	(gal)	STB	760	Date	5-23-17	☐ New System	☒ Repair	☐ Expansion	System Type: I (II) III IV V VI	
Pump Tank	—	(gal)	PT	—	Date	—	System Description:	Tank Replacement			
Pump Make	—	Model	—		Serial #	—	Repair System Description:				
# Nitrification Fields	EXT	# Lines	EXT		Linear Ft	EXT	Maintenance Agreement Required:	☐ YES	☒ NO		
Trench Width	EXT	Trench Bottom Depth(Low side)	EXT		Gravel Depth	EXT	☒ GRAVITY	☐ PRESSURE			

☒ Residence	No. Bedrooms	2	Water Supply	
☐ Business	No. Persons	4	☐ Private	
☐ Other	No. Employees		☒ Public	
☐ Slab	☒ Crawl Space		☐ Community	
☐ Basement w/plumbing			☐ Basement w/o plumbing	

Comments / Conditions: Crush + Fill or haul away existing Septic Tank.
Install new septic tank as shown. Install outlet filter

INITIAL SITE SKETCH

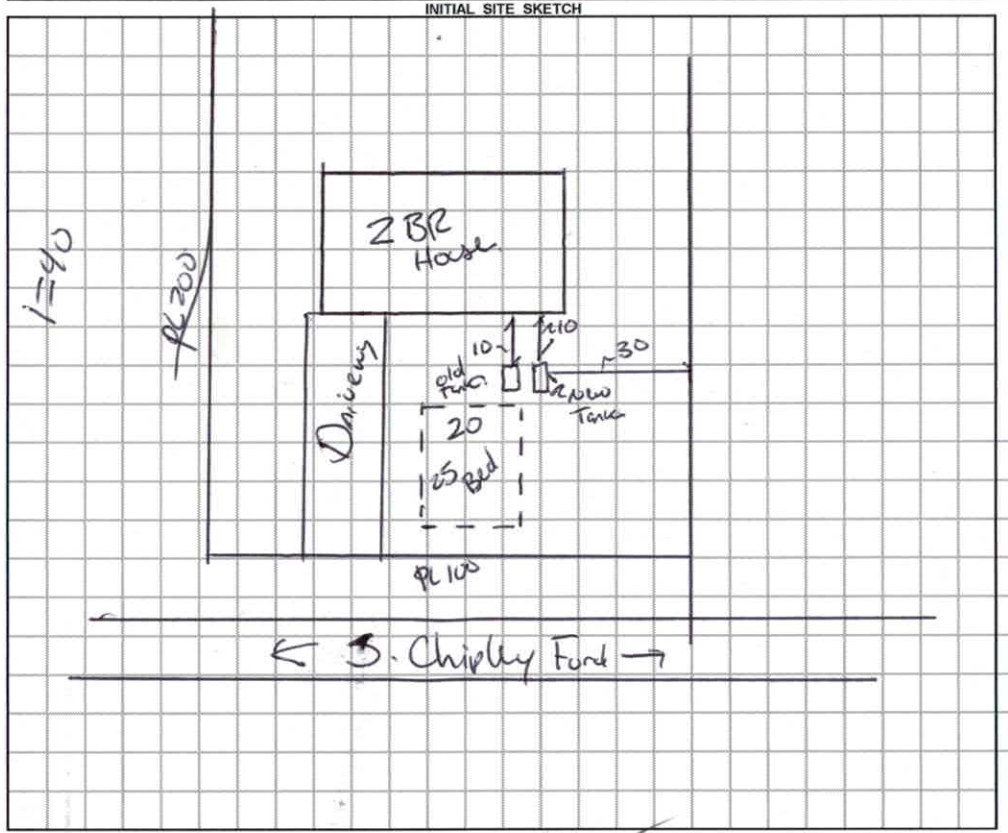

AS BUILT SKETCH

Installed as Drawn

Permit can be suspended or revoked if any false information is supplied toward securing the permit / any unauthorized changes are made to the site / any unauthorized changes are made in the installation of the system. **CONTACT A LOCATOR SERVICE PRIOR TO ANY EXCAVATION**

☐ **IMPROVEMENT PERMIT** ***with plat*** *valid without expiration.* ☒ **IMPROVEMENT PERMIT** ***with site plan*** *valid for 60 mos.* ☒ **AUTHORIZATION TO CONSTRUCT** *valid for period equal to IMPROVEMENT PERMIT--not to exceed 60 mo.*

Owner / Applicant Signature: Sent to Lentz per L. Wallace request Date: 8/18/17 Installed by: Jarrid Lentz

IMPROVEMENT PERMIT by: Benjamin Batten Date: 8/18/2017 OPERATION PERMIT by: Maria Dotson Date: 8/22/17

AUTHORIZATION TO CONSTRUCT by: Benjamin Batten Date: 8/18/2017 Existing System Inspected by: Date:

IREDELL COUNTY DEPARTMENT of ENVIRONMENTAL HEALTH

APPLICATION FORM

Application For: ( ) New Well Permit (X) Well Repair Permit ( ) Well Abandonment
( ) Septic Improvement Permit ( ) Authorization to Construct ( ) Existing System Inspection ( ) Septic System Repair

THE ABOVE PERMIT DOCUMENTS WILL BECOME INVALID IF INFORMATION PROVIDED ON THIS APPLICATION IS FALSIFIED OR CHANGED, OR IF THE SITE IS ALTERED. THE IMPROVEMENT PERMIT IS VALID FOR EITHER 60 MONTHS OR WITHOUT EXPIRATION DEPENDING UPON DOCUMENTATION SUBMITTED. APPLICATION WITH SITE PLAN 60 MONTHS, APPLICATION WITH COMPLETE, SCALED PLAT WITHOUT EXPIRATION. SEE 15A NCAC 18A .1937(f) FOR DETAILS.

Page 2: *Site Plan Worksheet* form MUST accompany this application

The following optional attachments may also be submitted: ( ) Survey Plat, scaled no more than 1 inch = 60 feet
Place an (X) beside whichever is submitted if applicable ( ) Custom Site Plan, scaled no more than 1 inch = 60 feet

Applicant Information: (PRINT CLEARLY)

Applicant Name: Lorene Wallace Address: 2610 S Ridley Ford Rd Zip: _____

Applicant Email: _____ Phone: _____ Alt. Phone: _____

Owner Name: Same Address: _____ Zip: _____

Owner Email: _____ Phone: _____ Alt. Phone: _____

Property Information:

Street Address: 2610 S Ridley Ford Rd

Subdivision Name: _____ Section/Phase: _____ Lot Number: _____

Driving Directions: _____

Site Development Information: *(check or complete ALL that apply*

( ) New Single Family Residence
( ) New Multi-Family Residence
( ) Accessory Building
( ) Bedroom(s) Addition
( ) Repair to failing septic system ___ Tank ___ Drain lines Describe Problem: _____

Maximum Number of Bedrooms: 2
Maximum Number of Occupants: 4
( ) Swimming Pool
( ) Other Addition/Structure: _____

CHECK FOUNDATION TYPE
(✓) Crawl Space Foundation
( ) Concrete Slab Foundation
( ) Basement with Plumbing
( ) Basement without Plumbing

Non-Residential Site Development: Type of Business: _____
Square Footage of Building: _____ Max. Number of Employees: _____ Max. Number of Seats/Beds/Other: _____

Water Supply: ( ) Replacement Well – Reason: _____
( ) Multi-connection Well Number of Houses: _____ Number of Persons: _____

( ) New Well ( ) Existing Well ( ) Community Well ( ) City Water (✓) Other Public Water

Desired Septic System Type: *(you may rank in order of preference)* Year existing system installed: 1959
( ) No Preference ( ) Alternative ( ) Conventional ( ) Innovative ( ) Modified Conventional ( ) Other: _____

Please answer the following to the best of your ability:

( ) Yes (✓) No Does the site contain any jurisdictional wetlands?
( ) Yes (✓) No Is any non-domestic sewage (i.e. industrial) to be generated?
( ) Yes (✓) No Is the site subject to approval by any other public agency?

I have read this application and certify that the information provided herein is true, complete, and correct. Authorized county and state officials are granted right of entry to conduct necessary inspections to determine compliance with applicable laws and rules. I understand that I am solely responsible for the proper identification and labeling of all property lines and corners and making the site accessible so that a complete site evaluation can be performed.

Signature: Lorene Wallace 9-17-2017
Property owner or owner's legal representative signature (SIGNATURE REQUIRED) DATE

Adrienne – Email Septic
Tank Replacement

IREDELL COUNTY DEPARTMENT OF ENVIRONMENTAL HEALTH

DOCUMENTATION TO AUTHORIZE AN OWNER'S LEGAL REPRESENTATIVE

Applications for permits require the "signature of the owner or owner's legal representative" (15A NCAC 18A .1937). If the owner does not sign the application himself or herself, they can submit any one of the following documents to designate their legal representative:

Power of Attorney; Real Estate Contract; Estate executor; Bankruptcy trustee; Court ordered guardianship

In the absence of the above documentation, the property owner may provide the local health department with documentation that designates a legal representative. A property owner may:

Complete this form to document his or her legal representative, or provide his or her own form that contains the information in this form.

If there are multiple property owners, then all property owners must sign the form that designates a legal representative.

By signing a form that designates a legal representative for purposes of 15A NCAC 18A .1937, the property owner authorizes that representative to act on their behalf in matters pertaining to the application and permitting process, including signing or receiving any application, document or permit. The owner retains full responsibility to meet all permit conditions specified by the local health department.

I, Lorene Wallace, am the legal owner(s) of the property located at 2010 S Chipley Ford, identified as PIN (Parcel Identification Number) _____, located in Iredell County, North Carolina.

I do hereby authorize (**print legal representative/company name**) _____, _____, to act as an agent on my behalf in applying for/signing/obtaining any of the documents described below.

- Application for Improvement Permit (IP) / Authorization to Construct (AC)
- Improvement Permit (IP) / Authorization to Construct (AC)
- Application for soil-site evaluation (new/repair)
- Application/permit for private drinking water well/well abandonment
- Application for Compliance Inspection

I agree to abide by all decisions and/or conditions between the legal representative acting on my behalf and the Iredell County Department of Public Health, Environmental Health Division.

Lorene Wallace 8-17-2017 _____ _____

Signature of Owner(s) Date Signature of Witness Date

Please return this signed form to the appropriate office:

Mooresville - Environmental Health
ronda.hart@co.iredell.nc.us
Fax: 704-662-3239
610 E. Center Avenue, Mooresville, NC 28115

Statesville - Environmental Health
adrienne.shea@co.iredell.nc.us
Fax: 704-871-3483
349 N. Center Street, Statesville, NC 28677


IREDELL COUNTY DEPARTMENT of ENVIRONMENTAL HEALTH

SITE PLAN WORKSHEET

SEE THE "SAMPLE SITE PLAN" BELOW. *INCOMPLETE SITE PLANS WILL BE RETURNED TO YOU FOR COMPLETION AND MAY RESULT IN A DELAY IN THE ISSUANCE OF YOUR SEPTIC SYSTEM OR WELL PERMIT!!!*

Place an (X) beside each item as you complete the site plan:

( ) **Property Line measurements are clearly identified**
( ) **All proposed structures are indicated**
( ) **Front and side setbacks from property line**
( ) **Preferred driveway location**
( ) **Preferred well location**
( ) **Preferred septic system location**
( ) **North arrow, or other sufficient indicator of direction**

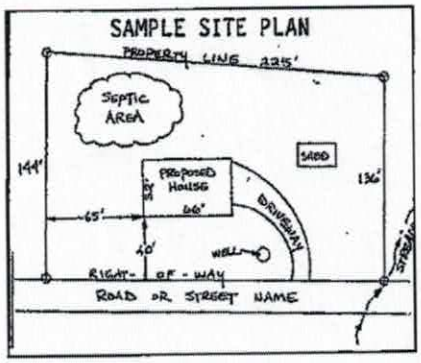


Circle N/A on the following if appropriate:

Location of septic systems and wells within 100' of your property	**N/A**
Location of easements and rights of ways on your property	**N/A**
Location of any designated wetlands on the property	**N/A**

USE THIS SPACE TO DRAW YOUR SITE PLAN

Show: proposed house or business footprint, wells, water lines, patios, pools and decks, and any other item that will occupy space on the site

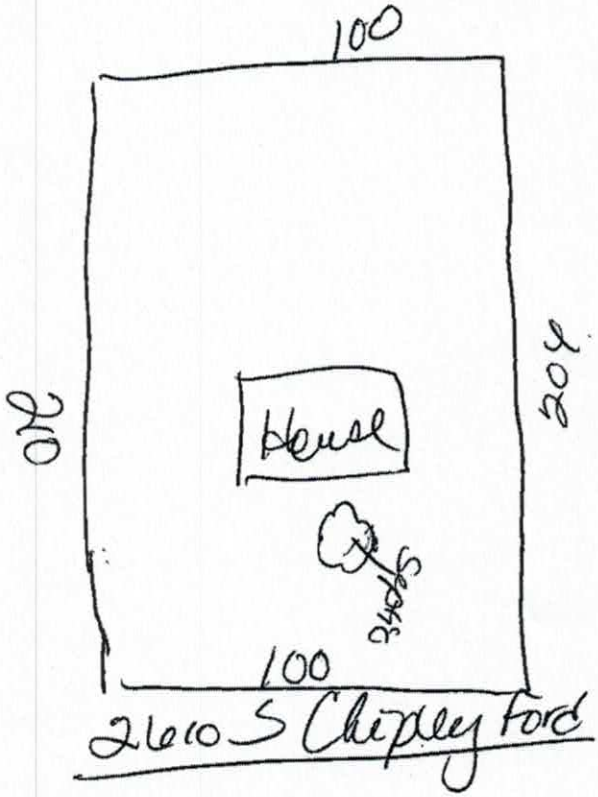

Signature: Lorene Wallace
Property owner or owner's legal representative signature (SIGNATURE REQUIRED)

8-17-2017
DATE