IREDELL COUNTY HEALTH DEPARTMENT

Statesville Phone TR 3-7271 Mooresville Phone NO 3-1271

PERMIT TO INSTALL SEPTIC TANK

Permit NO. _____ Permit Date 5 - 8 - 1959

Owner Frank Goforth Address Chipley Park

Installed By C Hoke Address RT 6


Location of Property 2nd new brick in Chipley Park or Chip. Rd on R

Tank		Capacity		Length of Lines		Fixtures	
Block	( )	800	(4)	150'	( )	No. of Baths	(')
Precast	(2)	900	( )	175'	( )	Dishwasher	( )
		1000	( )	200'	( )	Garbage Grdr.	( )
		1100	( )	225'	(4)	Auto-Washer	(1)
		1200	( )	250'	( )	Other	_____
		Other	_____	Other	_____		

NOTIFY HEALTH DEPARTMENT AT LEAST EIGHT HOURS BEFORE TANK IS TO BE INSPECTED.

Final Inspection 5 8 1959 Approved ( ) Disapproved ( )

Remarks Self Oper Pa TE H. central water supply. #2

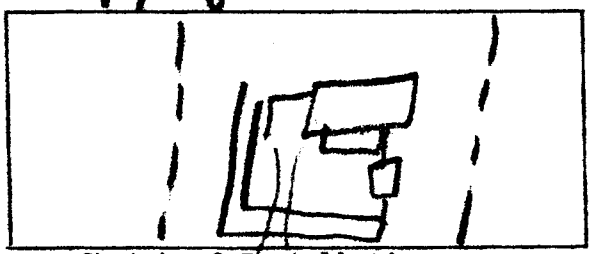

Sketch of Installation

R G L

Sanitarian