IREDELL COUNTY HEALTH DEPARTMENT

Statesville Phone TR 3-7271 Mooresville Phone NO 3-1271

PERMIT TO INSTALL SEPTIC TANK

Permit NO. _____ Permit Date 6-25 1964

Owner Hofstetler Homes Address Chipley Park

Installed By Hake Address Rte. 7 City


Location of Property Right off Chipley Ford Rd on to 1912 - 2nd on left

Tank		Capacity		Length of Lines		Fixtures	
Block	( )	1000	( )	225'	( )	No. of Baths	(2)
Precast	(✓)	1250	( )	250'	( )	[redacted]washer	( )
		1500	( )	Other _____		Garbage Grdr.	( )
		Other _____				Other _____	

NOTIFY HEALTH DEPARTMENT AT LEAST EIGHT HOURS BEFORE TANK IS TO BE INSPECTED.

Final Inspection 6-25 1964 Approved (✓) Disapproved ( )

Remarks Well 50'

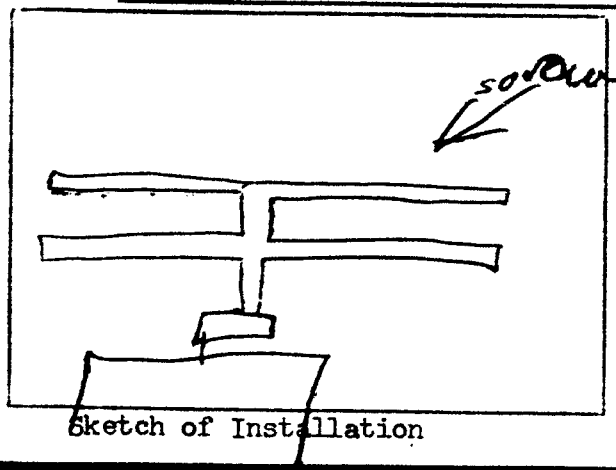

Sketch of Installation

RH

Sanitarian