3:38

IREDELL COUNTY HEALTH DEPARTMENT

STATESVILLE 704-878-5305 MOORESVILLE 704-664-5281

IMPROVEMENT PERMIT / AUTHORIZATION TO CONSTRUCT / OPERATION PERMIT / EXISTING SYSTEM INSPECTION

PERMIT# 21396 PIN# 4736-11-3675 4736714064 DATE 5-3-06

OWNER OR APPLICANT ADAM MAYNARD PHONE: Business 704-301-1402 Home

ADDRESS 246 CO BOUNDARY UNION GROVE NC 28689

LOCATION 21 N TO EI DOBBS TO LOOP LAKE TO LOT #36


SUBDIVISION DOBBS VALLEY BLOCK / SECTION II LOT 36 LOT AREA 1.656 SITE CLASS PS DESIGN FLOW 480 L.T.A.R. 1.3

Septic Tank: 1000 Gallons; STB 825 Date 10-3-06
Pump Tank: 1000 Gallons; PT 302 Date 12-17-06
Pump Make: Zoeller Model N151 Serial No.
Nitrification Field: No Fields 1 Square Feet 1200 Linear Feet 400
No Lines 3 Trench Width 36 Trench Bottom Depth 36"
☒ New System ☐ Repair ☐ Expansion System Type: I II III IV V VI
System Description: PUMP 35% REDUCTION
Repair System Description: LP 50% REDUCTION
Maintenance Agreement Required: ☐ Yes ☒ No
Gravel Depth N/A ☐ Gravity ☒ Pressure
☒ House/Mod. Home ☐ Mobile Home ☐ Business ☐ Other
No. Bedrooms 4 No. Persons 8 No. Employees
Water Supply: ☐ Individual ☒ Public ☐ Community
☐ Slab ☐ Crawl Space ☒ Basement w/plumbing ☐ Basement wo/plumbing


Comments/Conditions: ① INSTALL LINES ON CONTOURS 355.11' MAINTAIN SETBACKS

Comments/Conditions: INSTALL DRAIN LINES AT 36" DEEP

INITIAL SITE SKETCH

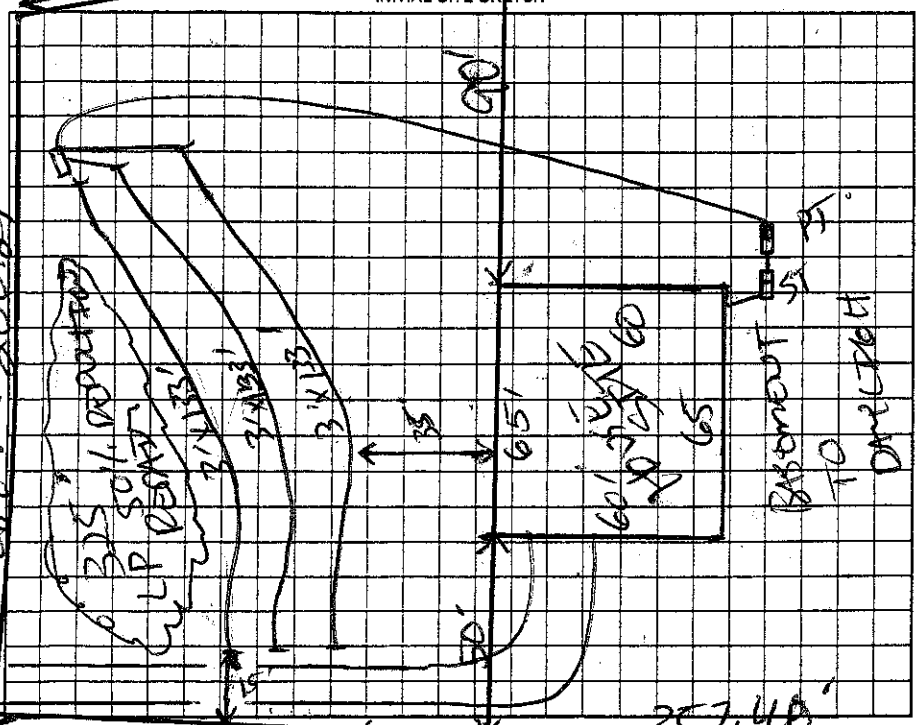

AS BUILT SKETCH

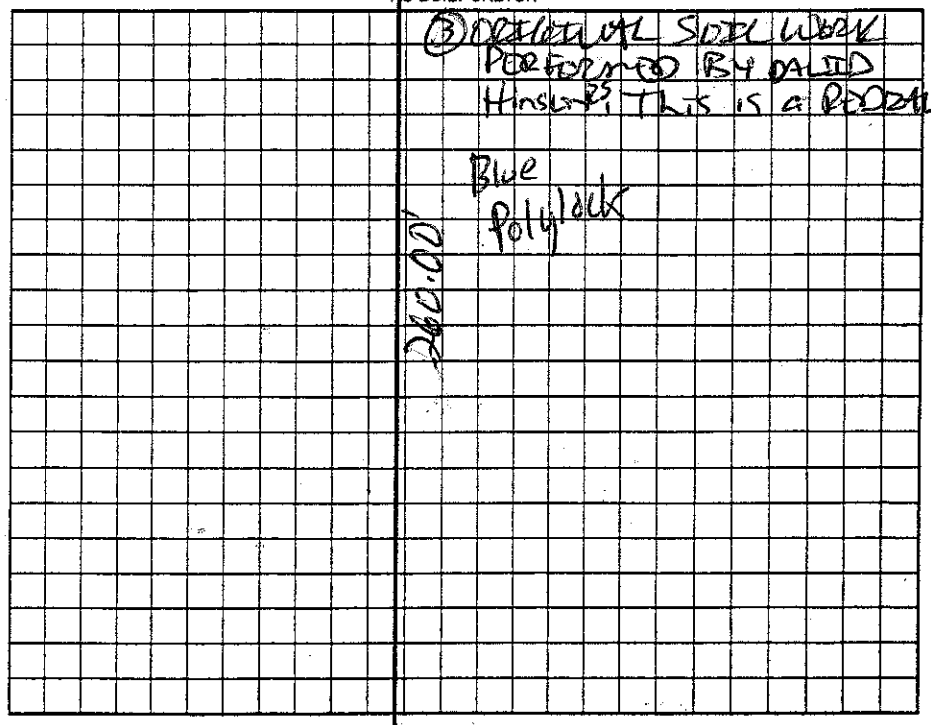

② RED FLAGS ON LOT AREA NOT FRONT OF HOME. SLIDE HOME 10' BACK DOWNSLOPE OF RED FLAGS; EXPLAINED TO OWNER.

③ ORIGINAL SOIL WORK PERFORMED BY DAVID HINSLEY. THIS IS A REDRAW.

Blue Polylock

"NOT TO SCALE"

CEDAR LANE DR 200.29'

Permit can be suspended or revoked if any false information is supplied toward obtaining the permit/any unauthorized changes are made to the site/any unauthorized changes are made in the installation of the system. Improvement Permit with plat valid without expiration. ☐ Improvement Permit with site plan valid for sixty months ☒ Authorization to Construct is valid for a period equal to that of Improvement Permit – not to exceed sixty months.

Signed: Adam Maynard date 5-4-06 Installed by: Rowan Septic

Improvement Permit by: date 5-3-06 Operation Permit by: date 5-9-07

Authorization to Construct by: date 5-3-06 Existing System Inspection by: date

HEALTH DEPT. COPY: WHITE OWNER COPY (FINAL): YELLOW OWNER COPY (INITIAL): PINK