This Permit replaces Previous one issued 3-7-00

IREDELL COUNTY HEALTH DEPARTMENT - *ENVIRONMENTAL HEALTH* ☑ STATESVILLE OFFICE 704-878-5305 ☐ MOORESVILLE OFFICE 704-664-5281

IMPROVEMENT PERMIT / AUTHORIZATION TO CONSTRUCT / OPERATION PERMIT / EXISTING SYSTEM INSPECTION

PERMIT # 175473 PIN # 4736716156 DATE 10-23-12

OWNER Stephen Fortner APPLICANT: KW Nicholson PHONE: Home/Cell # 704-878-2517 Business # 704-902-0799

SITE ADDRESS 188 Cedar Lake Dr. OWNER / APPLICANT ADDRESS 930 Argyle Court

SITE DIRECTIONS 11.5N TR Chipley Ford Rd. TR Fort Dobbs Rd TL Cedar Lake Dr.

SUBDIVISION Dobbs Valley BLOCK / SECTION P2 LOT # 37 LOT AREA 2.48 acres DESIGN FLOW 480gpd L.T.A.R. 0.25

Septic Tank 1600 Gallons: STB 1117/1000 Date 10-19-12
Pump Tank ____ Gallons: P T ____ Date ____
Pump Make ____ Model ____ Serial # ____
No. Nitrification Fields: 1 No. Lines 6 Linear Feet 480
Trench Width 36" Max. Trench Bottom Depth 36" Gravel Depth N/A

☑ New System ☐ Repair ☐ Expansion System Type I II (III) IV V VI
System Description: 25% Reduction
Repair System Description: Gravity PPBPS
Maintenance Agreement Required ☐ YES ☑ NO
☑ GRAVITY ☐ PRESSURE


☑ Residence No. Bedrooms 4
☐ Business No. Persons ____
☐ Other No. Employees ____
☐ Slab ☐ Crawl Space
☑ Basement w/plumbing ☐ Basement w/o plumbing

Water Supply: ☐ Private ☑ Public ☐ Community


Comments / Conditions: Install a 25% Reduction System on Contour with serial distribution.

- Quick4 Chambers installed
- 2" PVC tank marker installed
- Installed as drawn

INITIAL SITE SKETCH

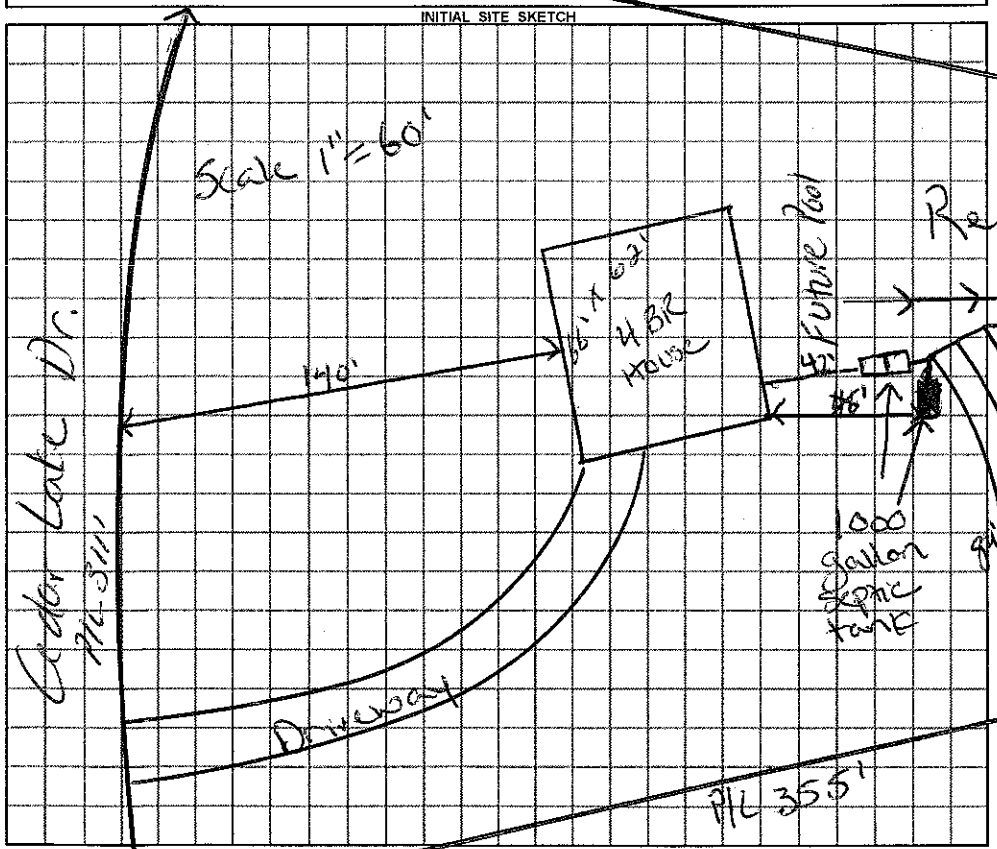

AS BUILT SKETCH

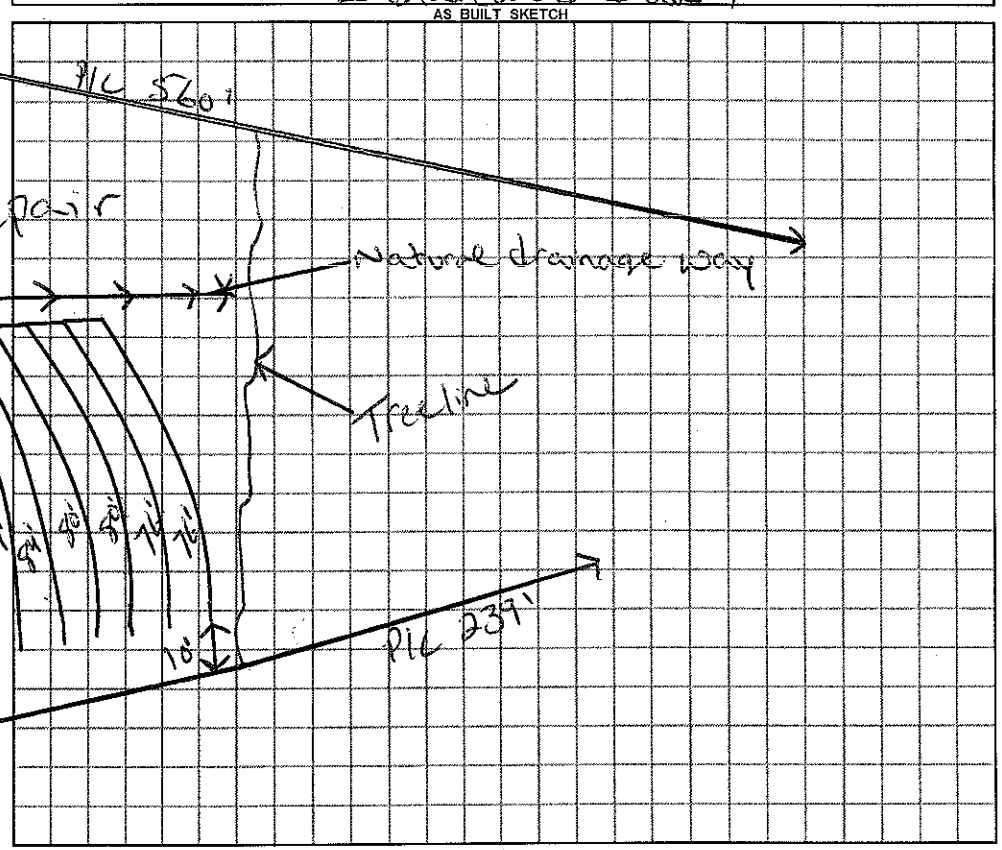

Permit can be suspended or revoked if any false information is supplied toward securing the permit / any unauthorized changes are made to the site / any unauthorized changes are made in the installation of the system.

☐ ***IMPROVEMENT PERMIT*** *with plat valid without expiration.* ☑ ***IMPROVEMENT PERMIT*** *with plat ~~valid without expiration~~ site plan valid 60 mo.* ☑ ***AUTHORIZATION TO CONSTRUCT*** valid for period equal to IMPROVEMENT PERMIT–not to exceed 60 mo.

Owner / Applicant Signature: Kent W Nich. Date 10-25-12 Installed by: Yountz Grading

IMPROVEMENT PERMIT by: Justin Henderson REHS Date 10-23-12 OPERATION PERMIT by: Justin Henderson REHS Date 7-16-13

AUTHORIZATION TO CONSTRUCT by: Justin Henderson REHS Date 10-23-12 Existing System Inspected by: ____ REHS Date ____

YOU SHOULD CONTACT A LOCATOR SERVICE PRIOR TO ANY EXCAVATION

White Copy – Environmental Health YELLOW COPY (Final) Owner / Applicant PINK COPY (Initial) Owner / Applicant