# IREDELL COUNTY HEALTH DEPARTMENT

STATESVILLE 704-878-5305 MOORESVILLE 704-664-5281

## IMPROVEMENT PERMIT / AUTHORIZATION TO CONSTRUCT / OPERATION PERMIT / EXISTING SYSTEM INSPECTION

PERMIT# 83861 PIN# 4736727707 DATE 9-22-99

OWNER OR CONTRACTOR Ze Lee Yang PHONE: Business 876 1305 Home

ADDRESS 122 Bristle Land Statesville N.C.

LOCATION 115 N TR Chipley Ft TR Clearview TR Bristle on left extent

SUBDIVISION Yang Property BLOCK / SECTION LOT 1 LOT AREA 12.54 acres SITE CLASS PS DESIGN FLOW 360 L.T.A.R. .13

Septic Tank: 1080 Gallons; STB 620 Date 7-1-99 | ☑ New System ☐ Repair System Type: ☐ I ☐ II ☐ IV ☐ V ☐ VI | ☐ House/Mod. Home No. Bedrooms 3 | Water Supply: ☑ Individual

Pump Tank: Gallons, PT Date | System Description: Conv. Gravity | ☑ Mobile Home No. Bathrooms 2 | ☐ Public

Pump Make: Model Serial No. | Repair System Description: " " " | ☐ Business No. Employees | ☐ Community


Nitrification Field: No Fields 1 Square Feet 1200 Linear Feet 400 | Maintenance Agreement Required ☐ Yes ☑ No | ☐ Other

No Lines 3 Trench Width 36" Max Trench Bottom Depth 36" Gravel Depth 12" | ☐ Slab ☑ Crawl Space ☐ Basement w/plumbing ☐ Basement wo/plumbing


Comments/Conditions:

Comments/Conditions

INITIAL SITE SKETCH

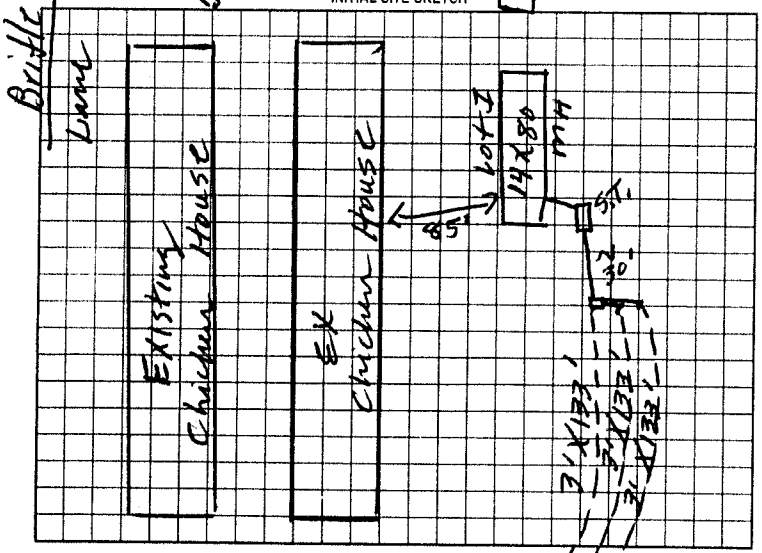


AS BUILT SKETCH

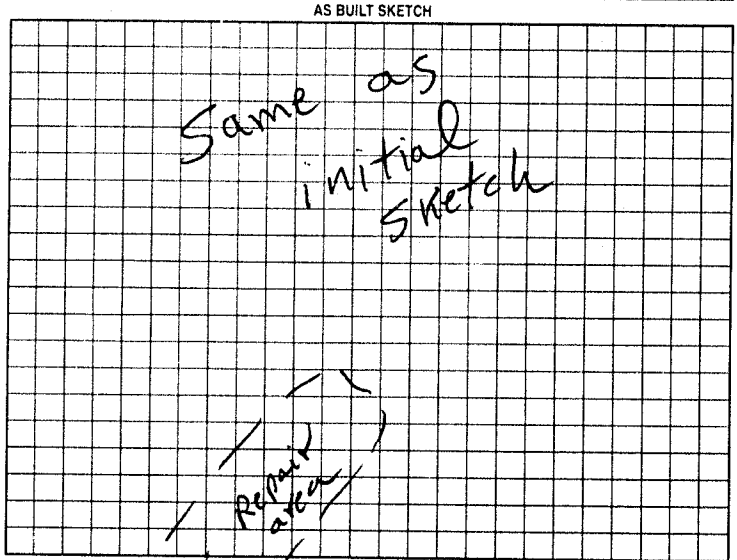


Permit can be suspended or revoked if any false information is supplied toward securing the permit/any unauthorized changes are made to the site/any unauthorized changes are made in the installation of the system. Improvement Permit with plat valid without expiration. Improvement Permit with site plan valid for sixty months. Authorization to Construct is valid for a period equal to that of Improvement Permit - not to exceed sixty months.

Signed: Ze Lee Yang date 9-22-99 Installed by: Sammy Reavis

Improvement Permit by: J.C. Moore date 9-22-99 Operation Permit by: J.C. Moore date 10-29-99

Authorization to Construct by: J.C. Moore date 9-22-99 Existing System Inspection by: date

HEALTH DEPT COPY WHITE OWNER COPY (FINAL) YELLOW OWNER COPY (INITIAL) PINK