IREDELL COUNTY HEALTH DEPARTMENT

Statesville Phone TR 3-7271 Mooresville Phone NO 3-1271

PERMIT TO INSTALL SEPTIC TANK

Permit No. 134 Permit Date 6-19 1972

Owner JERRY BARKER Address STATESVILLE, NC

Installed By HARLEE LACKEY Address STONY POINT, N.C


Location of Property CHIPLEY FORD RD. TURN RT ON RD. #1926 BEFORE CLEARVIEW ACRES. GO 1 MILE - TRAILER ON LEFT

Tank		Capacity		Length of Lines		Fixtures	
Block	( )	1000	(✓)	225'	(✓)	No. of Baths	(1)
Precast	(✓)	1250	( )	250'	( )	Dishwasher	( )
		1500	( )	Other		Garbage Grdr.	( )
		Other				Other	

NOTIFY HEALTH DEPARTMENT AT LEAST EIGHT HOURS BEFORE TANK IS TO BE INSPECTED.

Final Inspection 6-19 1972 Approved (✓) Disapproved ( )

Remarks NO WELL ON PROPERTY AT TIME OF INSP.

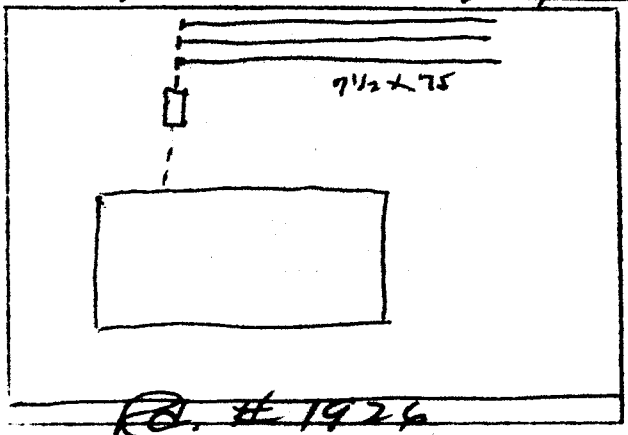

Sketch of Installation

Sanitarian