ITY HEALTH DEPARTMENT

Statesville Office (704) 878-5305 Mooresville Office (704) 660-3625 PERMIT # 204399

/ AUTHORIZATION TO CONSTRUCT / OPERATION PERMIT / EXISTING SYSTEM

PIN # 4736732406

Nicholson — APPLICANT ADDRESS: 384 Trinity Rd

Clearview Rd Statesville NC — PHONE: 704-838-2298 ALT. PHONE: N/A

115 to Chipley Ford to Clearview 1st on right

N/A — SECTION: N/A LOT # N/A LOT AREA: 1ac DESIGN FLOW: 240 L.T.A.R.: 0.3

Pump Tank ___ (gal) STB 760 Date 5-11-14

Pump Make N/A (gal) PT N/A Date N/A

Nitrification Fields 1 Model Poly Tech Serial # PL-68

Trench Width 36" # Lines 2 Linear Ft: 200

Max. Trench Bottom Depth 31" Gravel Depth N/A

☐ New System ☒ Repair ☐ Expansion System Type: I II (III) IV V VI

System Description: 25% Reduction

Repair System Description: N/A

Maintenance Agreement Required: ☐ YES ☒ NO

☒ GRAVITY ☐ PRESSURE

☒ Residence ☐ Business ☐ Other ☐ Slab ☐ Basement w/plumbing


No. Bedrooms 2 No. Persons 4 No. Employees ___ ☒ Crawl Space

Water Supply: ☒ Private ☒ Public ☐ Community


☐ Basement w/o plumbing

Comments / Conditions: Install 25% reduction on contour with serial distribution. Maintain 50' off well with any part of STS. Pump, crush & fill existing tank.

INITIAL SITE SKETCH

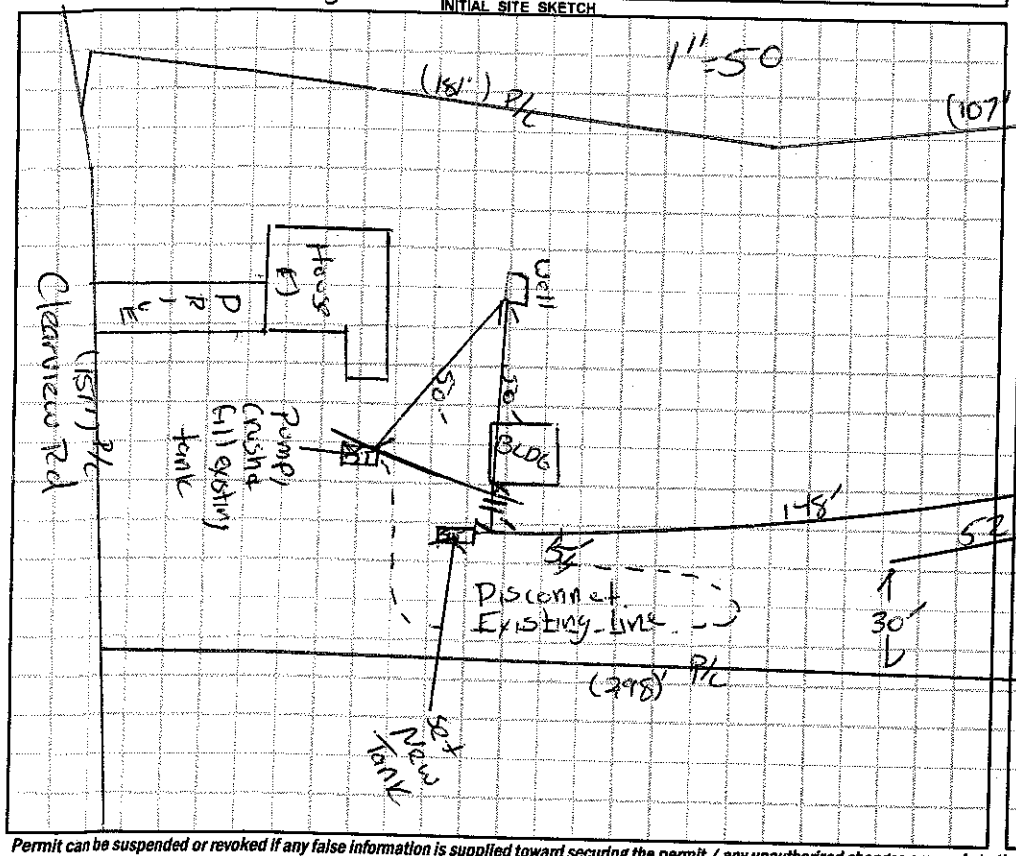

AS BUILT SKETCH

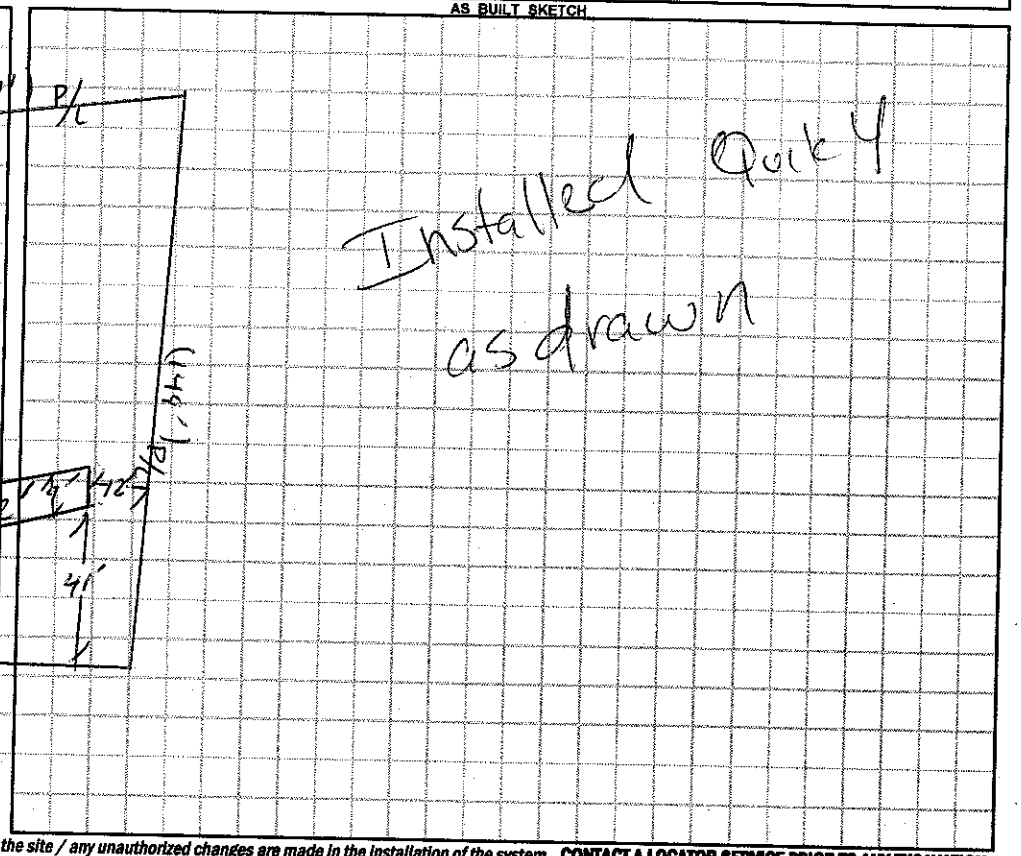

Permit can be suspended or revoked if any false information is supplied toward securing the permit / any unauthorized changes are made to the site / any unauthorized changes are made in the installation of the system. **CONTACT A LOCATOR SERVICE PRIOR TO ANY EXCAVATION**

☐ **IMPROVEMENT PERMIT** *with plat valid without expiration.* ☒ **IMPROVEMENT PERMIT** *with site plan valid for 60 mos.* ☒ **AUTHORIZATION TO CONSTRUCT** *valid for period equal to IMPROVEMENT PERMIT--not to exceed 60 mo.*

Owner / Applicant Signature: [signature] Date: 07-8-14

IMPROVEMENT PERMIT by: [signature] Date: 07/10/14

AUTHORIZATION TO CONSTRUCT by: [signature] Date: 07/16/14

Installed by: A-1 Backhoe

OPERATION PERMIT by: [signature] Date: 07/29/13

Existing System Inspected by: ___ Date: ___

Health Dept. Copy - WHITE Applicant (Final Approval) - YELLOW