IREDELL COUNTY HEALTH DEPARTMENT

STATESVILLE 704-878-5305 (CI) MOORESVILLE 704-664-5281

IMPROVEMENT PERMIT / AUTHORIZATION TO CONSTRUCT / OPERATION PERMIT / EXISTING SYSTEM INSPECTION

PERMIT# 132215 PIN# 4736736025 DATE 12-7-05

OWNER OR CONTRACTOR Related Group Inc. PHONE: Business 704 895 7459 Home 704 906 4912

ADDRESS 201 Clearview Rd Statesville

LOCATION Chipley Ford North, (R) on Clearview - property on right

SUBDIVISION Nicole Acres BLOCK / SECTION ____ LOT 1 LOT AREA .42 SITE CLASS PS DESIGN FLOW 360 L.T.A.R. .3

Septic Tank: 1000 Gallons; STB 425 Date 2-5-06
Pump Tank: ____ Gallons; PT ____ Date ____
Pump Make: ____ Model ____ Serial No. ____
Nitrification Field: No Fields 1 Square Feet 1200 Linear Feet 300
No Lines 4 Trench Width 3 Max Trench Bottom Depth 36 Gravel Depth n/a

☒ New System ☐ Repair System Type: I (II) III IV V VI
System Description: 25% Reduction System Gravity
Repair System Description: ~~25%~~ 50% Reduction Pump
Maintenance Agreement Required: ☐ Yes ☒ No

☒ House/Mod. Home No. Bedrooms 3
☐ Mobile Home No. Bathrooms ____
☐ Business No. Employees ____
☐ Other ____


☐ Slab ☒ Crawl Space ☐ Basement w/plumbing ☐ Basement wo/plumbing

Water Supply: ☐ Individual ☒ Public ☐ Community

Comments:/Conditions:

Comments:/Conditions:
Polylock Filter
No Risers

INITIAL SITE SKETCH

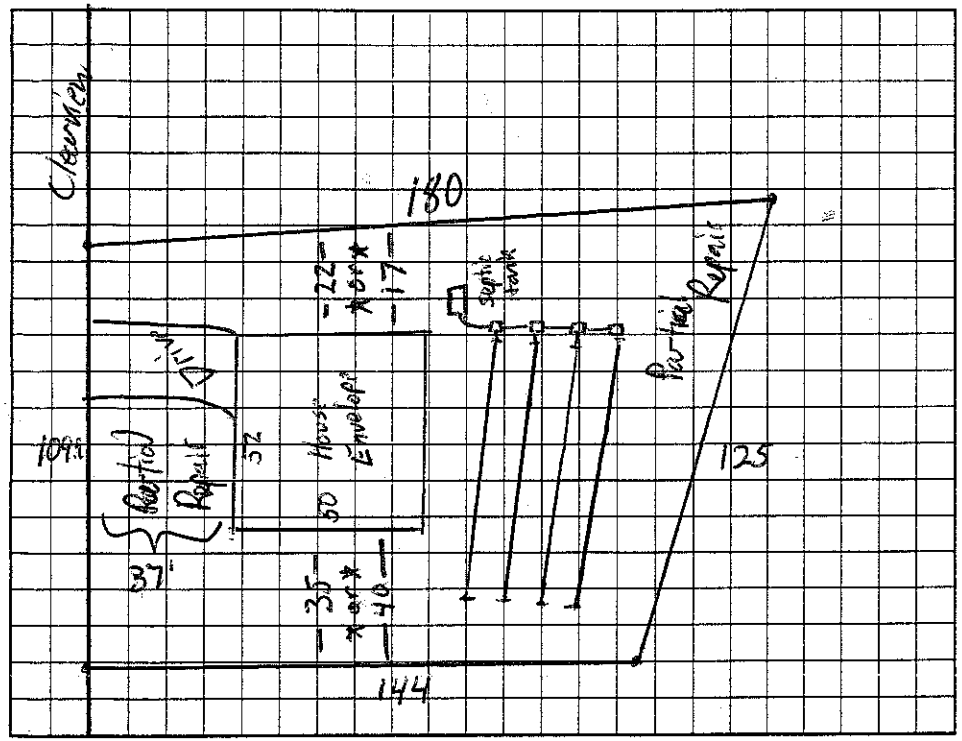

AS BUILT SKETCH

Permit can be suspended or revoked if any false information is supplied toward securing the permit/any unauthorized changes are made to the site/any unauthorized changes are made in the installation of the system. Improvement Permit with plat valid without expiration. Improvement Permit with site plan valid for sixty months. Authorization to Construct is valid for a period equal to that of Improvement Permit – not to exceed sixty months.

Signed: ____ date 12/7/05 Installed by: Rowan Septic

Improvement Permit by: ____ date 12-7-05 Operation Permit by: ____ date 4-7-06

Authorization to Construct by: ____ date 12-7-05 Existing System Inspection by: ____ date ____

HEALTH DEPT. COPY: WHITE OWNER COPY (FINAL): YELLOW OWNER COPY (INITIAL): PINK