IREDELL COUNTY HEALTH DEPARTMENT

STATESVILLE 704-878-5305 MOORESVILLE 704-664-5281

IMPROVEMENT PERMIT / AUTHORIZATION TO CONSTRUCT / OPERATION PERMIT / EXISTING SYSTEM INSPECTION

PERMIT# 11669 PIN# 4736-74-8045 DATE 12/15/03

OWNER OR CONTRACTOR Phillip Shapiro PHONE: Business _____ Home (704) 906-4912

ADDRESS 123 Julia Circle Davidson, N.C. 28036

LOCATION Hwy 21 North (L) Fort Dobbs (R) Cooper Farm Rd. (L) Clearview Rd. on left (lot beside 191 Clearview)

SUBDIVISION Nicole Acres BLOCK / SECTION — LOT 2 LOT AREA .4490 Acres SITE CLASS. P5 DESIGN FLOW 360 L.T.A.R. .25 gpd/ft²

Septic Tank: 1,000 Gallons; STB 825 Date 11-5-03
Pump Tank: _____ Gallons; PT _____ Date _____
Pump Make: _____ Model Equate Serial No. _____
Nitrification Field: No Fields 1 Square Feet 1440 Linear Feet 360
No Lines 5 Trench Width 36" Max Trench Bottom Depth 30" Gravel Depth NA

☒ New System ☐ Repair System Type: I, II, III, IV, V, VI
System Description: Gravity, 25% Reduction
Repair System Description: Gravity, 50% Reduction
Maintenance Agreement Required: ☐ Yes ☒ No

☒ House/Mod. Home ☐ Mobile Home ☐ Business ☐ Other
No. Bedrooms 3 No. Bathrooms 2 No. Employees ____


☐ Slab ☒ Crawl Space ☐ Basement w/plumbing ☐ Basement wo/plumbing

Water Supply: ☐ Individual ☒ Public ☐ Community

Comments:/Conditions: (1) Install lines on contour (3) Maintain proper setbacks

Comments:/Conditions:
- Infiltrator Chambers Installed - 58 qt
- Poly lok Filter Installed
- Septic System Installed before House built.

INITIAL SITE SKETCH Scale 1" = 40'

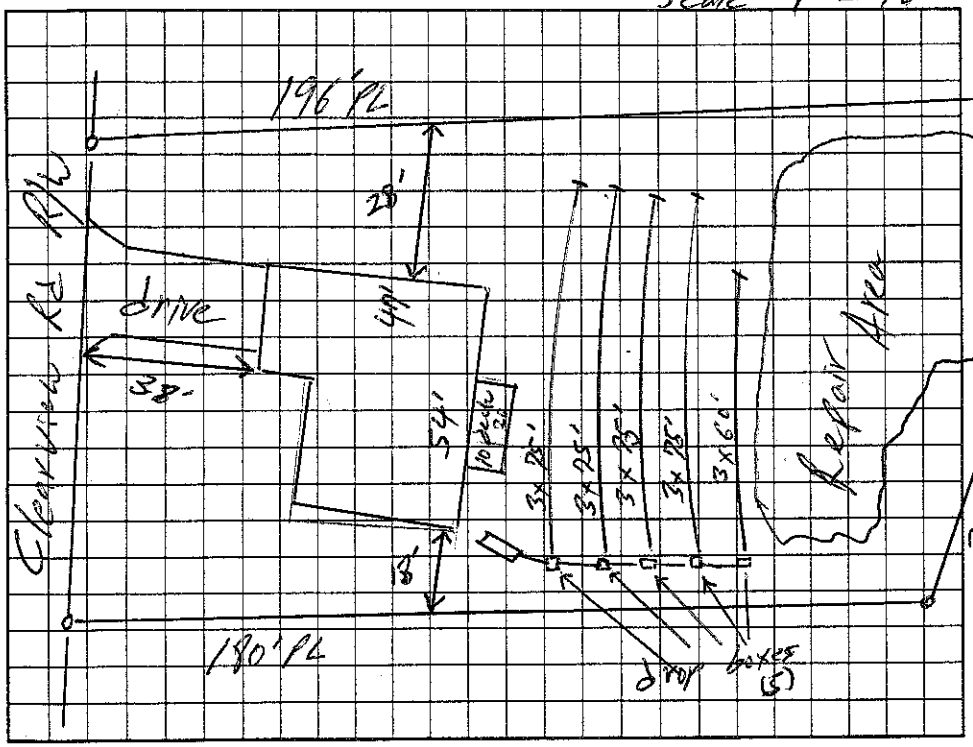

AS BUILT SKETCH

Installed As Shown per Initial Site Sketch

Line Length - 11 Chambers - Top Line
12 Chambers - 2nd Line
12 Chambers - 3rd Line
12 Chambers - 4th Line
11 Chambers - Bottom Line
58 - Total

Permit can be suspended or revoked if any false information is supplied toward securing the permit/any unauthorized changes are made to the site/any unauthorized changes are made in the installation of the system. Improvement Permit with plat valid without expiration. Improvement Permit with site plan valid for sixty months. Authorization to Construct is valid for a period equal to that of Improvement Permit – not to exceed sixty months.

Signed: _____ date 12/16/03 Installed by: C & W Grading / Rowan Septic

Improvement Permit by: William O. Johnson date 12/15/03 Operation Permit by: William O. Johnson date 1/23/04

Authorization to Construct by: William O. Johnson date 12/15/03 Existing System Inspection by: _____ date _____

HEALTH DEPT. COPY: WHITE OWNER COPY (FINAL): YELLOW OWNER COPY (INITIAL): PINK