IREDELL COUNTY HEALTH DEPARTMENT

Statesville Phone TR 3-7271 Mooresville Phone NO 3-1271

PERMIT TO INSTALL SEPTIC TANK

Permit No. 148 Permit Date _____ 19__

Owner Bobby Cranks Address Statesville

Installed By Lackey Brothers Address Stony Point

Location of Property Out Chipley Ford Rd to Cleaveland

Acres. Last Rd. Last house on right at


end of circle.

Tank		Capacity		Length of Lines		Fixtures	
Block	(✓)	1000	(✓)	225'	(✓)	No. of Baths	(2)
Precast	( )	1250	( )	250'	( )	Dishwasher	( )
		1500	( )	Other _____		Garbage Grdr.	( )
		Other _____				Other _____	

NOTIFY HEALTH DEPARTMENT AT LEAST EIGHT HOURS BEFORE TANK IS TO BE INSPECTED.

Final Inspection 2-16-1971 Approved (✓) Disapproved ( )

Remarks _____

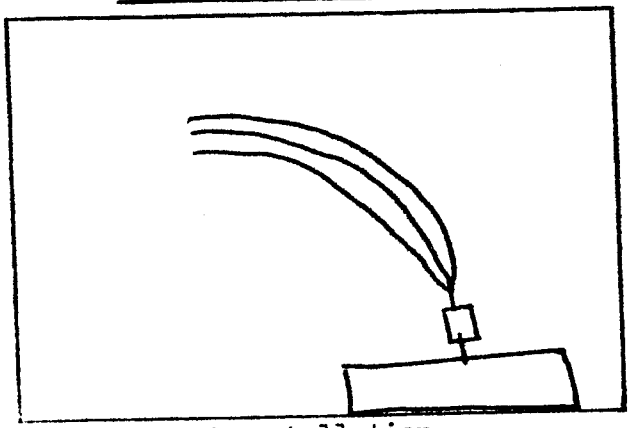

Sketch of Installation

Luzz S. Hale

Sanitarian