IREDELL COUNTY HEALTH DEPARTMENT

THIS PERMIT REDUCES PREVIOUS ISSUED 2-5-02

STATESVILLE 704-878-5305 MOORESVILLE 704-664-5281

IMPROVEMENT PERMIT / AUTHORIZATION TO CONSTRUCT / OPERATION PERMIT / EXISTING SYSTEM INSPECTION

PERMIT# 104127 PIN# 4736-76-5456 DATE 2-9-04

OWNER OR CONTRACTOR ANDREW SHERRILL PHONE: Business Home 704-876-3496

ADDRESS 164 CLEARCREST DR STATESVILLE, NC 28625

LOCATION NC 115 N, TR S, CHIPLEY FORD RD, TR AT BOX # 2508 ~1800' BACK OFF ROAD

SUBDIVISION BLOCK / SECTION LOT LOT AREA 116.67 ACRES SITE CLASS. PS DESIGN FLOW 360 L.T.A.R. 0.30 GPD/FT²

Septic Tank: 1000 Gallons; STB 1012 Date 7-22-03
Pump Tank: Gallons; PT Date
Pump Make: Model Serial No.
Nitrification Field: No Fields 1 Square Feet 1200 Linear Feet 400
No Lines FIVE Trench Width 36" Max Trench Bottom Depth 36" Gravel Depth 12"

☑ New System ☐ Repair System Type: I, II, III, IV, V, VI
System Description: CONVENTIONAL GRAVITY
Repair System Description: 25% REDUCTION, GRAVITY
Maintenance Agreement Required: ☐ Yes ☑ No


☑ House/Mod. Home No. Bedrooms 3
☐ Mobile Home No. Bathrooms 3
☐ Business No. Employees
☐ Other
☐ Slab ☐ Crawl Space ☑ Basement w/plumbing ☐ Basement wo/plumbing

Water Supply: ☑ Individual ☐ Public ☐ Community
WELL

Comments:/Conditions: GRADE AREA OVER DRAINFIELD TO PROVIDE UNIFORM SLOPE & LANDSCAPE

Comments:/Conditions: SEPTIC TANK WITH RISERS INSTALLED USING "TUFFITE" FILTER. CHROMA 2 MOTTLES NOTED IN TRENCHES DURING FINAL INSPECTION.

INITIAL SITE SKETCH

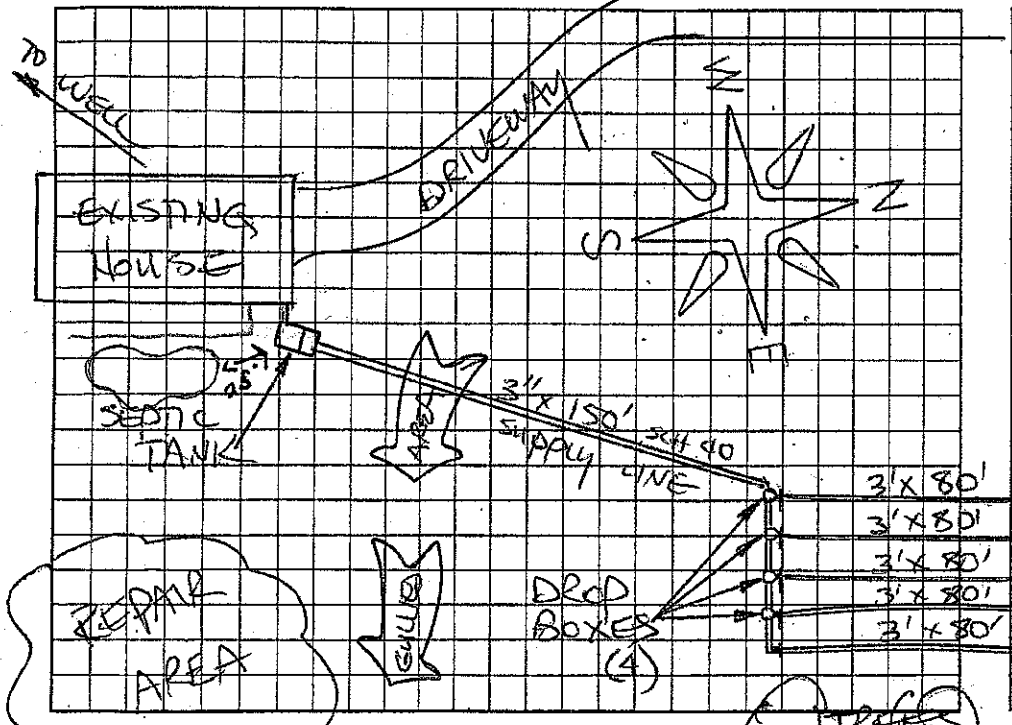

AS BUILT SKETCH

Location of the proposed Swimming Pool addition does not appear to impact the existing on-site septic system.**NOTE: Kept 15' from exist. Septic Tank

REHS

Date: 6 February 2012

ICHD-Environmental Health Division

SYSTEM INSTALLED ACCORDING TO INITIAL SITE SKETCH

Permit can be suspended or revoked if any false information is supplied toward securing the permit, any unauthorized changes are made to the site/any unauthorized changes are made in the installation of the system. Improvement Permit with plat valid without expiration. Improvement Permit with site plan valid for sixty months. Authorization to Construct is valid for a period equal to that of Improvement Permit – not to exceed sixty months.

Signed: date 2-9-04

Improvement Permit by: STEVE HEDRICK date 2-9-04

Authorization to Construct by: STEVE HEDRICK date 2-9-04

Installed by: DALE WINGLER

Operation Permit by: STEVE HEDRICK date 2-25-04

Existing System Inspection by: date 6 February 2012

HEALTH DEPT. COPY: WHITE OWNER COPY (FINAL): YELLOW OWNER COPY (INITIAL): PINK