IREDELL COUNTY HEALTH DEPARTMENT - *ENVIRONMENTAL HEALTH* ☒ STATESVILLE OFFICE 704/878-5305 ☐ MOORESVILLE OFFICE 704-654-5281

THIS PERMIT VOIDS PREVIOUS ISSUED 4-29-08

IMPROVEMENT PERMIT / AUTHORIZATION TO CONSTRUCT @ / OPERATION PERMIT @ / EXISTING SYSTEM INSPECTION

PERMIT # 16479I PIN # 4736-80-2974 DATE 2-7-11

OWNER Curtis Gregory APPLICANT: PHONE: Home/Cell # 704 878 0752 Business #

SITE ADDRESS 191 Natures Trail OWNER / APPLICANT ADDRESS

SITE DIRECTIONS Hwy 21N (L) Fort Dobbs, (R) on Natures Trail - 10th lot on left

SUBDIVISION Dobbs Valley BLOCK / SECTION LOT # 14 LOT AREA 1.5 DESIGN FLOW 600 L.T.A.R. .7

Septic Tank 1500 Gallons: STB 529 Date 1-8-8

Pump Tank Gallons: P T Date

Pump Make Model Serial #

No. Nitrification Fields: 1 No. Lines 5 Linear Feet 500

Trench Width 36" Max. Trench Bottom Depth 36" Gravel Depth

☒ New System ☐ Repair ☐ Expansion System Type I II (III) IV V VI

System Description: 25% Reduction Gravity

Repair System Description: 25% Reduction Gravity

Maintenance Agreement Required ☐ YES ☒ NO

☒ GRAVITY ☐ PRESSURE

☒ Residence No. Bedrooms 5

☐ Business No. Persons

☐ Other No. Employees

☐ Slab ☒ Crawl Space


☐ Basement w/plumbing ☐ Basement w/o plumbing

Water Supply: ☐ Private ☒ Public ☐ Community

Comments / Conditions

1" = 100'

INITIAL SITE SKETCH

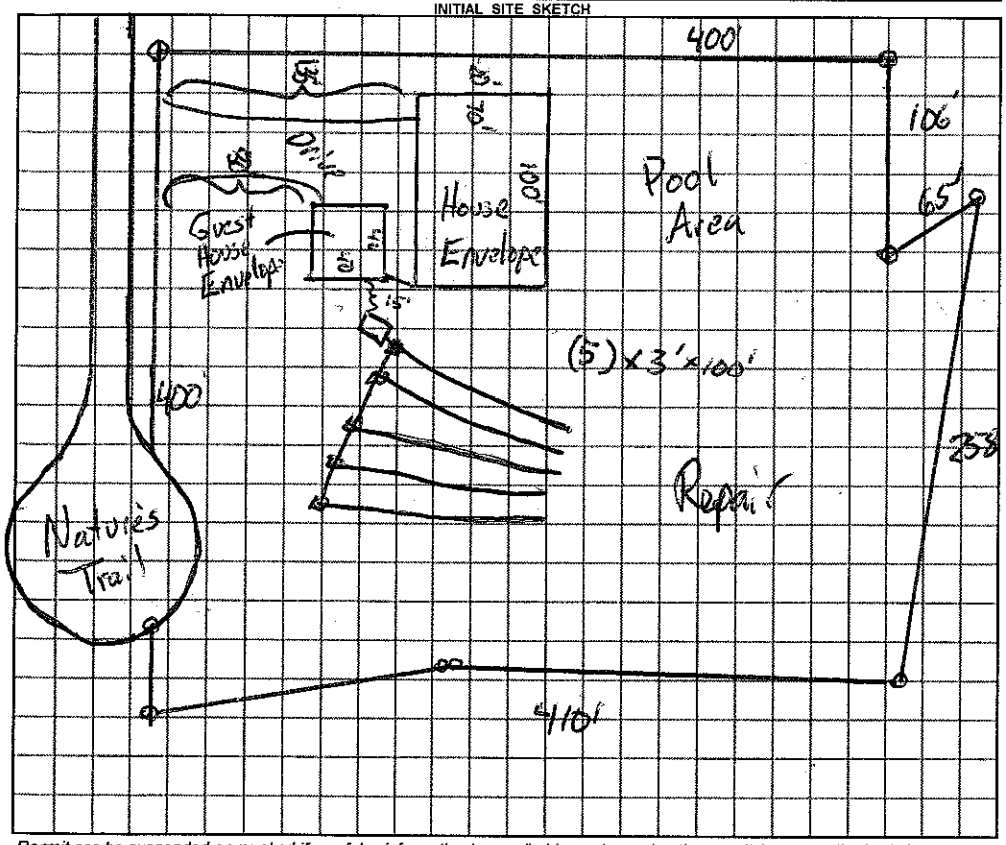

AS BUILT SKETCH

Permit can be suspended or revoked if any false information is supplied toward securing the permit / any unauthorized changes are made to the site / any unauthorized changes are made in the installation of the system.

☐ *IMPROVEMENT PERMIT with plat valid without expiration.* ☒ *IMPROVEMENT PERMIT with plat valid without expiration.* ☒ *AUTHORIZATION TO CONSTRUCT* valid for period equal to IMPROVEMENT PERMIT--not to exceed 60 mo.

60 mos with site plan

Owner / Applicant Signature: Date 2-14-11 Installed by: Fourite Grading

IMPROVEMENT PERMIT by: REHS Date 2-7-11 OPERATION PERMIT by: REHS Date 6-29-11

AUTHORIZATION TO CONSTRUCT by: REHS Date 2-7-11 Existing System Inspected by: REHS Date

YOU SHOULD CONTACT A LOCATOR SERVICE PRIOR TO ANY EXCAVATION

White Copy – Environmental Health YELLOW COPY (Final) Owner / Applicant PINK COPY (Initial) Owner / Applicant