IREDELL COUNTY HEALTH DEPARTMENT

Statesville Office (704) 878-5305 Mooresville Office (704) 660-3625 PERMIT # 21062

IMPROVEMENT PERMIT / AUTHORIZATION TO CONSTRUCT / OPERATION PERMIT / EXISTING SYSTEM

PIN # 4736804701

APPLICANT: Joseph Reagan APPLICANT ADDRESS: 153 Natures Trail

SITE ADDRESS: 183 Natures Trail PHONE: 704-425-5046 ALT. PHONE: N/A

SITE DIRECTIONS: Hwy 115 N TR N Chipley Ford Rd. TR Fort Dobbs Rd TL Natures Trail

SUBDIVISION: Dobbs Valley SECTION: N/A LOT # 15 LOT AREA: 1.56 acres DESIGN FLOW: 480 gpd L.T.A.R.: Existing


Septic Tank	Ex (gal)	STB	Date	☐ New System ☐ Repair ☐ Expansion	System Type: I (II) III IV V VI	☑ Residence	No. Bedrooms 4
Pump Tank	(gal)	PT	Date	System Description:	Conventional	☐ Business	No. Persons 8
Pump Make	Model		Serial #	Repair System Description:		☐ Other	No. Employees
# Nitrification Fields	Ex # Lines Ex		Linear Ft: Ex	Maintenance Agreement Required:	☐ YES ☑ NO	☐ Slab	☑ Crawl Space
Trench Width	Ex Max. Trench Bottom Depth Ex		Gravel Depth Ex		☑ GRAVITY ☐ PRESSURE	☐ Basement w/plumbing	☐ Basement w/o plumbing

Water Supply: ☐ Private ☑ Public ☐ Community


Comments / Conditions:

- All Pools shall be a minimum of 15' away from all components of septic tank system + repair area.

INITIAL SITE SKETCH

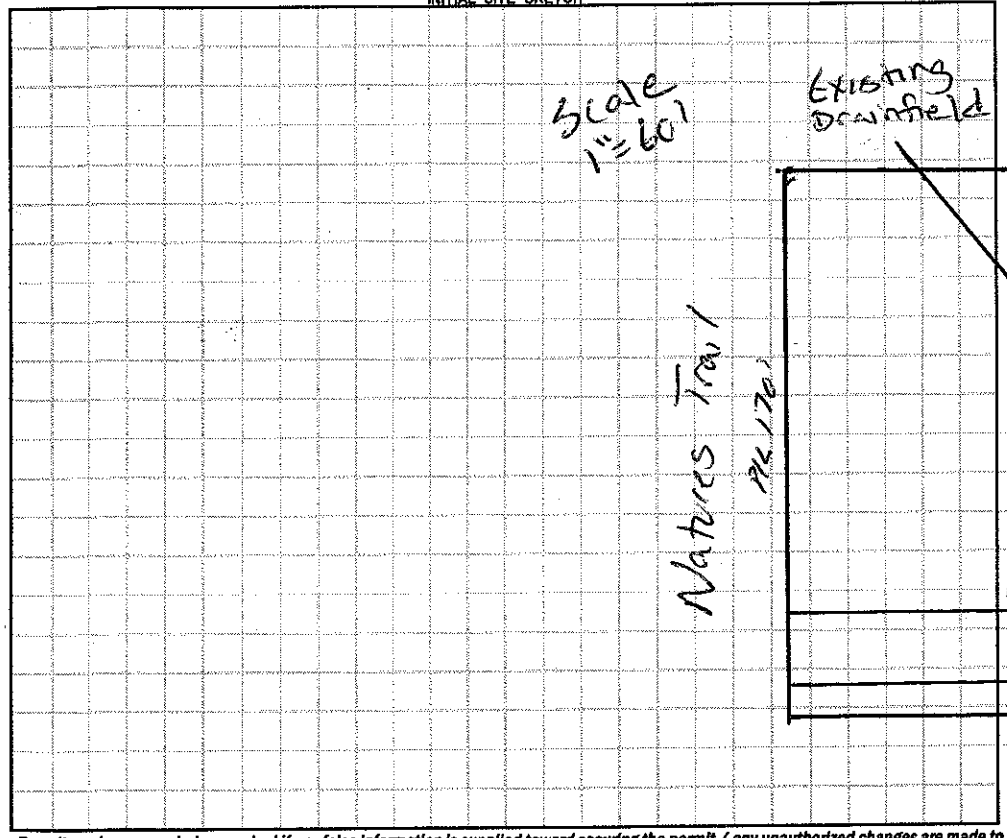

AS BUILT SKETCH

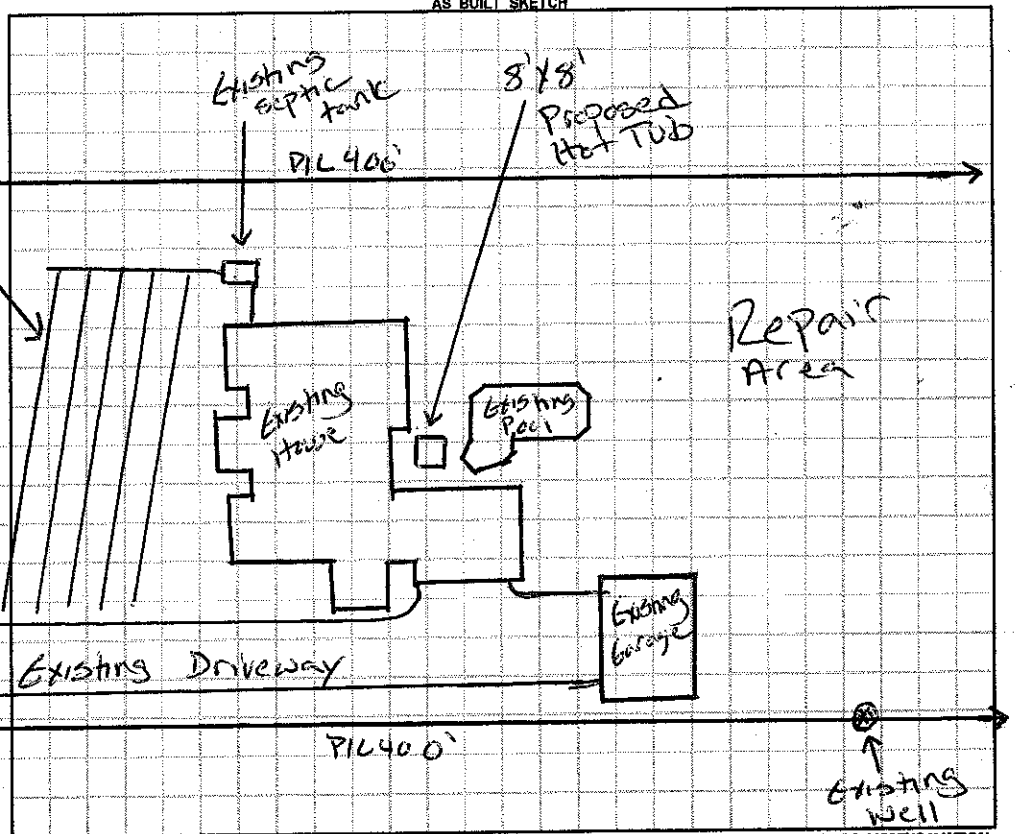

Permit can be suspended or revoked if any false information is supplied toward securing the permit / any unauthorized changes are made to the site / any unauthorized changes are made in the installation of the system. **CONTACT A LOCATOR SERVICE PRIOR TO ANY EXCAVATION**

☐ **IMPROVEMENT PERMIT** *with plat valid without expiration.* ☐ **IMPROVEMENT PERMIT** *with site plan valid for 60 mos.* ☐ **AUTHORIZATION TO CONSTRUCT** *valid for period equal to IMPROVEMENT PERMIT--not to exceed 60 mo.*

Owner / Applicant Signature: [signature] Date: 6/1/15 Installed by:

IMPROVEMENT PERMIT by: Date: OPERATION PERMIT by: Date:

AUTHORIZATION TO CONSTRUCT by: Date: Existing System Inspected by: Justin Henderson Date: 5-28-15

Health Dept. Copy - WHITE Applicant (Final Approval) - YELLOW Applicant (Conditional Approval) - PINK