IREDELL COUNTY HEALTH DEPARTMENT

This permit Voids permit dated 9/4/02.

STATESVILLE 704-878-5305 CI MOORESVILLE 704-664-5281

IMPROVEMENT PERMIT / AUTHORIZATION TO CONSTRUCT / OPERATION PERMIT / EXISTING SYSTEM INSPECTION

PERMIT# 107637 PIN# 4736-90-12-4446 80-5513 DATE 7/31/03

OWNER OR CONTRACTOR R.W. Nicholson, Inc PHONE: Business (704) 878-2517 Home

ADDRESS 930 Argyle Court Statesville N.C 28677

LOCATION From 21 N. (L) Fort Dobbs Rd, (R) Natures Trail, lot on left

SUBDIVISION Dobbs Valley BLOCK / SECTION LOT 16 LOT AREA 2.48 Ac SITE CLASS. 05 DESIGN FLOW 360 L.T.A.R. .30 GPD/Sq Ft

Septic Tank: 4 000 Gallons; STB 1012 Date 8-29-03

Pump Tank: Gallons; PT Date

Pump Make: Model Serial No.

Nitrification Field: No Fields 1 Square Feet 1200 Linear Feet 400

No Lines 4@100' Trench Width 36" Max Trench Bottom Depth 28" Gravel Depth 12"

~~New System~~ ☐ Repair System Type: I, (II), III, IV, V, VI

System Description: Gravity Conventional

Repair System Description: Pump, Conventional

Maintenance Agreement Required: ☐ Yes ~~No~~

~~House~~/Mod. Home No. Bedrooms 3

☐ Mobile Home No. Bathrooms 2

☐ Business No. Employees

☐ Other

☐ Slab ☐ Crawl Space ~~Basement w/plumbing~~ ☐ Basement wo/plumbing


Water Supply: ☐ Individual ~~Public~~ ☐ Community

Comments/Conditions:


(1) Install lines on contour (2) Install French Drain 40" deep to daylight (min 12" below Septic Trench Bottom depth)

Comments:/Conditions: Tuff-Tite Filter & ST marker Installed

INITIAL SITE SKETCH

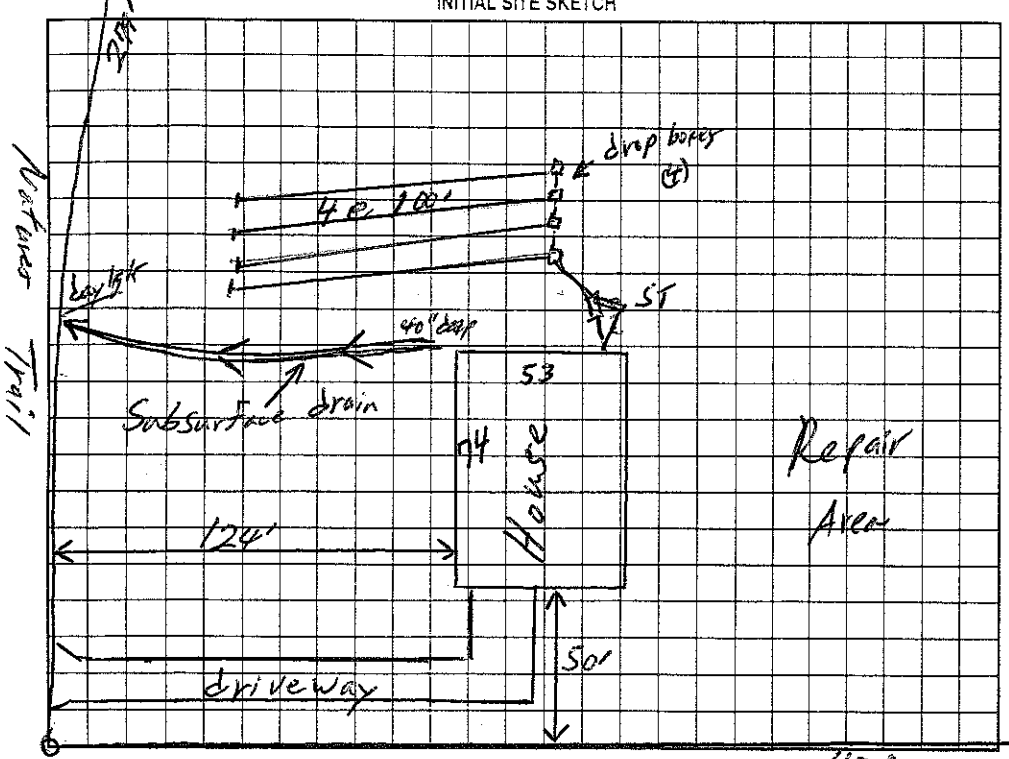

AS BUILT SKETCH

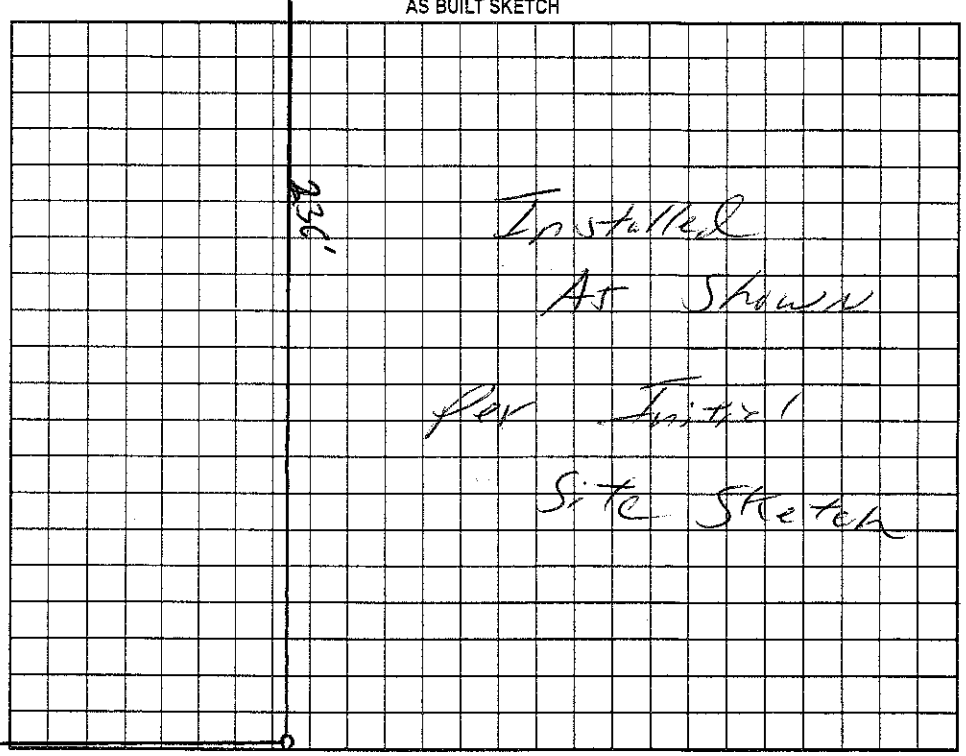

400'

Permit can be suspended or revoked if any false information is supplied toward securing the permit/any unauthorized changes are made to the site/any unauthorized changes are made in the installation of the system. Improvement Permit with plat valid without expiration. Improvement Permit with site plan valid for sixty months. Authorization to Construct is valid for a period equal to that of Improvement Permit – not to exceed sixty months.

Signed: [signature] date 8-6-03

Improvement Permit by: William O. Johnson date 7/31/03

Authorization to Construct by: William O. Johnson date 7/31/03

Installed by: David Yountz

Operation Permit by: William O. Johnson date 2/25/04

Existing System Inspection by: date

HEALTH DEPT. COPY: WHITE OWNER COPY (FINAL): YELLOW OWNER COPY (INITIAL): PINK