69 PEEP 62 WIDE

# IREDELL COUNTY HEALTH DEPARTMENT

STATESVILLE 704-878-5305 CALLED IN MOORESVILLE 704-664-5281

## IMPROVEMENT PERMIT / AUTHORIZATION TO CONSTRUCT / OPERATION PERMIT / EXISTING SYSTEM INSPECTION

PERMIT# 107644 PIN# ~~4736-10-8477.19~~ 4736-80-7002 DATE 8/9/4/02

OWNER OR CONTRACTOR CHARLES NANTZ PHONE: Business 872-4749 Home

ADDRESS 491 FORT DOBBS RD - STATESVILLE NC 28625

LOCATION 21 N - TL FORT DOBBS - TR NATURES TRAIL - ON LT

SUBDIVISION DOBBS VALLEY BLOCK / SECTION LOT 19 LOT AREA 1.125AC SITE CLASS. PS DESIGN FLOW 480 GPD L.T.A.R. .30-60/KI

Septic Tank: 1000 Gallons; STB 1012 Date 1-21-05

Pump Tank: Gallons; PT Date

Pump Make: Model Serial No.

Nitrification Field: No Fields 1 Square Feet 1620 Linear Feet 540

No Lines 5 Trench Width 36" Max Trench Bottom Depth 36" Gravel Depth 12"

☑ New System ☐ Repair System Type: I (II) III, IV, V, VI

System Description: GRAVITY CONVENTIONAL

Repair System Description: PUMP SAME

Maintenance Agreement Required: ☐ Yes ☑ No

☐ ~~House/Mod. Home~~ No. Bedrooms 4

☐ Mobile Home No. Bathrooms 4

☐ Business No. Employees

☐ Other

☐ Slab ☑ Crawl Space ☐ Basement w/plumbing ☐ Basement wo/plumbing


Water Supply: ☐ Individual ☑ Public ☐ Community

Comments:/Conditions:


Comments:/Conditions: Approved 70'x62' HOUSE DOTTED ON PERMIT, 40' OFF SIDE P/L

Yellow (T.A-Tite) Filter Tank w/risers

INITIAL SITE SKETCH 1"=50'

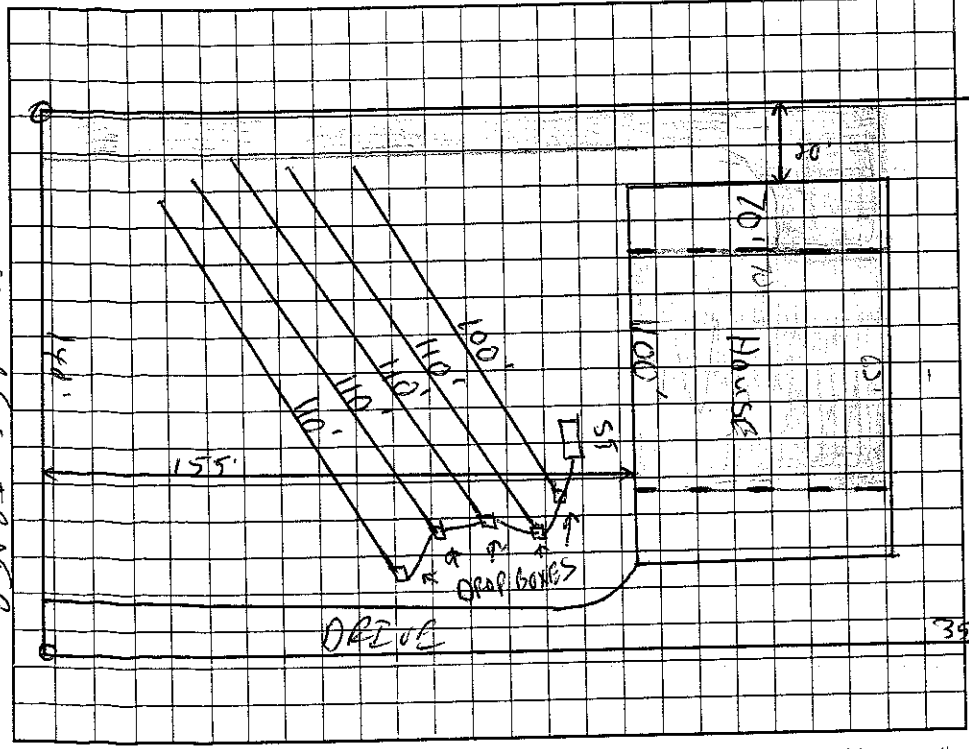


AS BUILT SKETCH

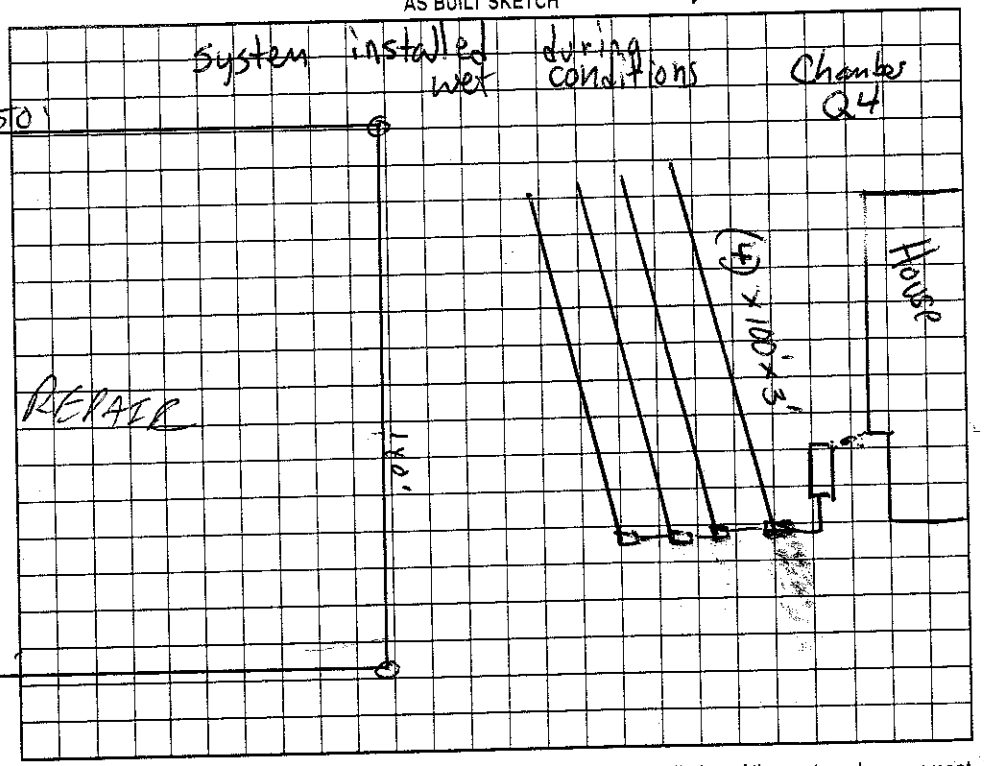


Permit can be suspended or revoked if any false information is supplied toward securing the permit/any unauthorized changes are made to the site/any unauthorized changes are made in the installation of the system. Improvement Permit with plat valid without expiration. Improvement Permit with site plan valid for sixty months. Authorization to Construct is valid for a period equal to that of Improvement Permit – not to exceed sixty months.

Signed: date 9-5-02 Installed by: Tommy Frye

Improvement Permit by: date 9/4/02 Operation Permit by: James Stewart date 1-10-06

Authorization to Construct by: date 5-11-05 Existing System Inspection by: date

HEALTH DEPT. COPY: WHITE OWNER COPY (FINAL): YELLOW OWNER COPY (INITIAL): PINK