2:00

IREDELL COUNTY HEALTH DEPARTMENT

STATESVILLE 704-878-5305 (CI) MOORESVILLE 704-664-5281

IMPROVEMENT PERMIT / AUTHORIZATION TO CONSTRUCT / OPERATION PERMIT / EXISTING SYSTEM INSPECTION

PERMIT# 21727 PIN# 4736-71-5673 24 DATE 5-10-06

OWNER OR APPLICANT Jeffrey Waid PHONE: Business 828-322-8404 Home 828-478-4497

ADDRESS PO Box 516 Catawba NC 28609

LOCATION

SUBDIVISION Dobbs Valley BLOCK / SECTION II LOT 47 LOT AREA 1.977 SITE CLASS. B DESIGN FLOW 480 L.T.A.R. .125

Septic Tank: 1000 Gallons; STB 577 Date 1-25-07
Pump Tank: Gallons; PT Date
Pump Make: Model Serial No.
Nitrification Field: No Fields Square Feet 1900 Linear Feet 480
No Lines 4 Trench Width 36" Max Trench Bottom Depth 24" Gravel Depth

☑ New System ☐ Repair ☐ Expansion System Type: I II III IV V VI
System Description: 25% Gravity
Repair System Description: LP Pump
Maintenance Agreement Required: ☐ Yes ☐ No

☑ House/Mod. Home ☐ Mobile Home ☐ Business ☐ Other
No. Bedrooms 4 No. Persons No. Employees

Water Supply: ☐ Individual ☑ Public ☐ Community

☐ Gravity ☐ Pressure ☐ Slab ☐ Crawl Space ☐ Basement w/plumbing ☐ Basement wo/plumbing


Comments:/Conditions:

Install on Contour
Maintain all setbacks

Comments:/Conditions:

Distribution box
(4) speed levels
24" Iron at Bottom

INITIAL SITE SKETCH

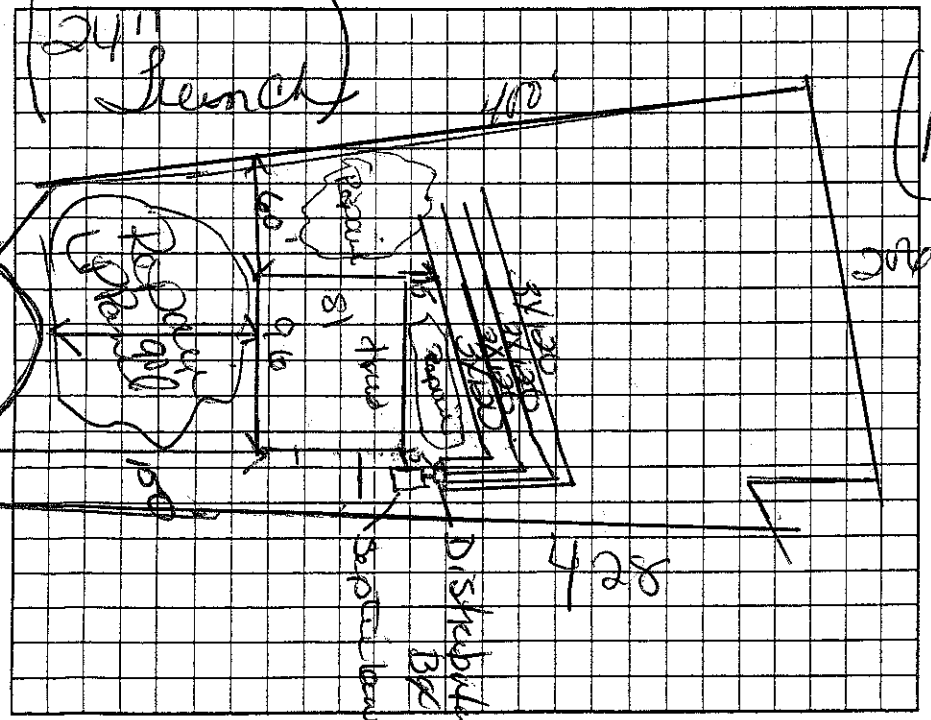

AS BUILT SKETCH

1" = 100'

Permit can be suspended or revoked if any false information is supplied toward securing the permit/any unauthorized changes are made to the site/any unauthorized changes are made in the installation of the system. Improvement Permit with plat valid without expiration. ☐ Improvement Permit with site plan valid for sixty months ☐ Authorization to Construct is valid for a period equal to that of Improvement Permit – not to exceed sixty months.

Signed: Jeffrey Waid date

Improvement Permit by: Keith Cook date 5-10-06

Authorization to Construct by: Keith Cook date 5-11-06

Installed by: Tommy Frye

Operation Permit by: [signature] date 1-25-07

Existing System Inspection by: date

HEALTH DEPT. COPY: WHITE OWNER COPY (FINAL): YELLOW OWNER COPY (INITIAL): PINK