IREDELL COUNTY HEALTH DEPARTMENT

Statesville Phone TR 3-7271 Mooresville Phone NO 3-1271

PERMIT TO INSTALL SEPTIC TANK

Permit NO. _____ Permit Date Feb 15 19 68

Owner Paul Payne Address Statesville

Installed By Roy Lee Address Statesville


Location of Property out Fort Dobbs Rd to Intt Rd to Right Fourth House on Left

Tank		Capacity		Length of Lines		Fixtures	
Block	( )	1000	(✓)	225'	(✓)	No. of Baths	( )
Precast	(✓)	1250	( )	250'	( )	Dishwasher	( )
		1500	( )	Other _____		Garbage Grdr.	( )
		Other _____				Other _____	

NOTIFY HEALTH DEPARTMENT AT LEAST EIGHT HOURS BEFORE TANK IS TO BE INSPECTED.

Final Inspection Oct 19__ Approved ( ) Disapproved ( )

Remarks _____

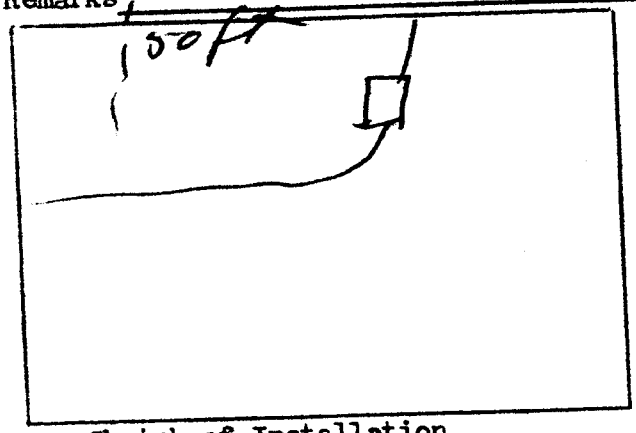

Sketch of Installation

_____

Sanitarian