IREDELL COUNTY HEALTH DEPARTMENT

Statesville Phone TR 3-7271 Mooresville Phone NO 3-1271

PERMIT TO INSTALL SEPTIC TANK

Permit No. 180 Permit Date June 3 1970

Owner Shirley Ashley Address Rt. 8 Statesville

Installed By H.L. Hedrick Address Rt. 8 Statesville


Location of Property Chipley Ford Road to 1926. One mile on right at Road 1940

Tank		Capacity		Length of Lines		Fixtures	
Block	( )	1000	(✓)	225'	(✓)	No. of Baths	(2)
Precast	(✓)	1250	( )	250'	( )	Dishwasher	( )
		1500	( )	Other		Garbage Grdr.	( )
		Other				Other	

NOTIFY HEALTH DEPARTMENT AT LEAST EIGHT HOURS BEFORE TANK IS TO BE INSPECTED.

Final Inspection June 3 1970 Approved (✓) Disapproved ( )

Remarks

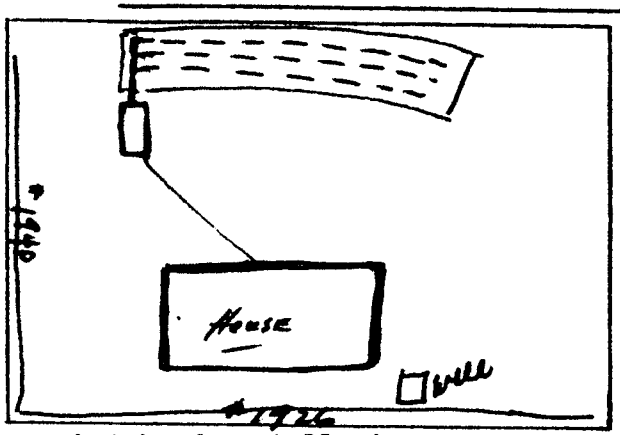

Sketch of Installation

Sanitarian