IREDELL COUNTY HEALTH DEPARTMENT

Statesville Phone TR 3-7271 Mooresville Phone No. 664-5281

PERMIT TO INSTALL SEPTIC TANK

Permit No. _____ Permit Date 12 Sept 1973

Owner William S. Forbes Address Statesville N.C.

Installed By Harlee Lakey Address _____


Location of Property N. of Chipley Ford Rd. to Rd. # 1926 on Right. Go 9/10 mile & Sid St. on Rt. First house on Left.

Tank	Capacity	Length of Lines	Fixtures
Block ( )	1000 ( )	225' ( )	No. of Baths ( )
Precast ~~( )~~	~~1250~~ ( )	250' ( )	Dishwasher (✓)
Repair	1500 ( )	Other 240	Garbage Grdr. ( )
	Other _____		Other _____

NOTIFY HEALTH DEPARTMENT AT LEAST EIGHT HOURS BEFORE TANK IS TO BE INSPECTED.

Final Inspection 12 Sept 1973 Approved (✓) Disapproved ( )

Remarks _____

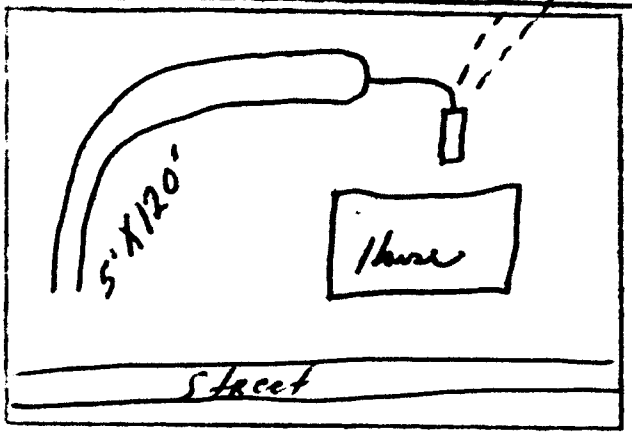

Sketch of Installation

County Water.
Dual fall on lines
Dual Sep.

William M. Howard
Sanitarian