IREDELL COUNTY HEALTH DEPARTMENT

STATESVILLE 704-878-5305 MOORESVILLE 704-664-5281

IMPROVEMENT PERMIT / AUTHORIZATION TO CONSTRUCT / OPERATION PERMIT / EXISTING SYSTEM INSPECTION

PERMIT# 104333 PIN# 4936-85-4992 DATE 1/31/02

OWNER OR CONTRACTOR Jack Borders PHONE: Business (704) 881-0025 Home —

ADDRESS 188 Knox Farm Road Statesville N.C. 28677

LOCATION Hwy 21 N ⓒ Fort Dobbin ⓡ Cooper Farm ⓛ Clearview ⓡ Rocky Ridge Drive, on Right

SUBDIVISION Yellow Brook BLOCK / SECTION — LOT 13 LOT AREA — SITE CLASS 5 DESIGN FLOW 360 L.T.A.R. .25

Septic Tank: 1000 Gallons: STB 1012 Date 2-8-02
Pump Tank: — Gallons: PT — Date —
Pump Make: — Model — Serial No —
Nitrification Field: No Fields 1 Square Feet 90" to 1440' Linear Feet 360
No Lines 4 Trench Width 36" Max Trench Bottom Depth 30" Gravel Depth —

X New System Repair System Type: I II III IV V VI
System Description Gravity, 25% Reduction
Repair System Description Pump, 50% Reduction
Maintenance Agreement Required Yes X No

X House/Mod. Home No. Bedrooms 3
Mobile Home No. Bathrooms 2
Business No. Employees —
Other —
Slab X Crawl Space Basement w/plumbing Basement wo/plumbing


Water Supply: ☐ Individual X Public ☐ Community

Comments/Conditions ① Install Liner on Contour ② Maintain Proper Setback 5


Comments/Conditions — Pump/Float/Filter Installed
— Septic Tank Marker Installed
— 60 Infiltrator Chambers Installed (not to Scale)

1" = 40'

INITIAL SITE SKETCH

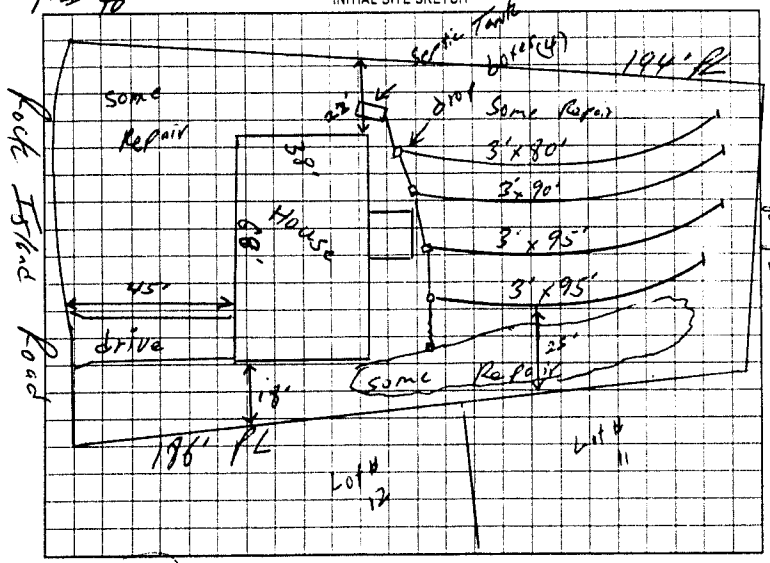

AS BUILT SKETCH

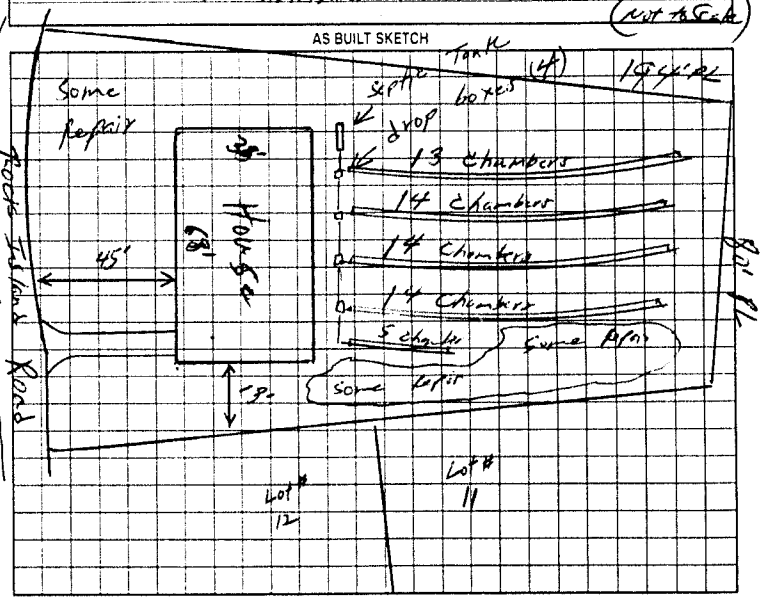

Permit can be suspended or revoked if any false information is supplied toward securing the permit; any unauthorized changes are made to the site; any unauthorized changes are made in the installation of the system. Improvement Permit with plat valid without expiration. Improvement Permit with site plan valid for sixty months. Authorization to Construct is valid for a period equal to that of Improvement Permit – not to exceed sixty months.

Signed: [signature] date 1/31/02 Installed by: Dale Fox

Improvement Permit by: William O. Johnson date 1/31/02 Operation Permit by: William O. Johnson date 6/7/02

Authorization to Construct by: William O. Johnson date 1/31/02 Existing System Inspection by: — date —

HEALTH DEPT. COPY WHITE OWNER COPY (FINAL) YELLOW OWNER COPY (INITIAL) PINK