IREDELL COUNTY HEALTH DEPARTMENT

Statesville Phone TR 3-7271 Mooresville Phone NO 3-1271

PERMIT TO INSTALL SEPTIC TANK

Permit NO. D D Nantz Subdiv. Permit Date Jan 6 - 1965

Owner Robbins Address

Installed By C Hoke Address


Location of Property Nantz Subdiv - off Chipley Ford Rd.

Tank		Capacity		Length of Lines		Fixtures	
Block	( )	800	( )	150'	( )	No. of Baths	(2)
Precast	(✓)	900	( )	175'	( )	Dishwasher	( )
		1000	(✓)	200'	( )	Garbage Grdr.	( )
		1100	( )	225'	(✓)	Auto-Washer	( )
		1200	( )	250'	( )	Other	
		Other		Other			

NOTIFY HEALTH DEPARTMENT AT LEAST EIGHT HOURS BEFORE TANK IS TO BE INSPECTED.

Final Inspection 1-6 1965 Approved (✓) Disapproved ( )

Remarks FHA # - Very high water table - Clay sub-soil - lines Rock wet base - well 60 ft.

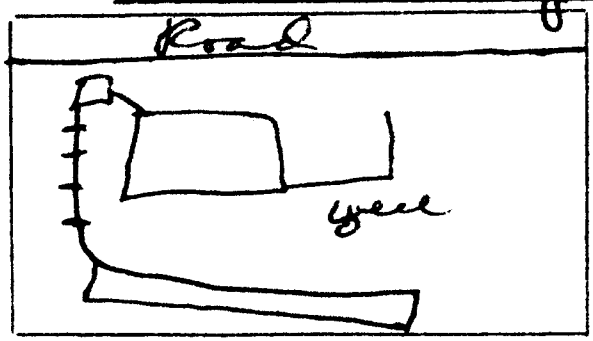

Sketch of Installation

R. L.

Sanitarian