IREDELL COUNTY HEALTH DEPARTMENT

~~Statesville Phone IR 3-7271~~ Mooresville Phone NO 3-1271

PERMIT TO INSTALL SEPTIC TANK 19 23

Permit No. 497

Owner Arnold Robbins Address Statesville,

Installed By Henry Sigmon Address Statesville


Location of Property Chipley Ford Rd. Rt ex Rd #1926 - DD Nantz Sub-Division

Tank	Capacity		Length of Lines		Fixtures	
Block	1000	( )	225'	( )	No. ~~of Baths~~	( )
Precast Repair	1250	( )	250'	( )	Dishwasher	( )
	1500	( )	Other 200		Garbage Grdr.	( )
	Other				Other	

NOTIFY HEALTH DEPARTMENT AT LEAST EIGHT HOURS BEFORE TANK IS TO BE INSPECTED.

Final Inspection 6-19 1923 Approved (✓) Disapproved ( )

Remarks

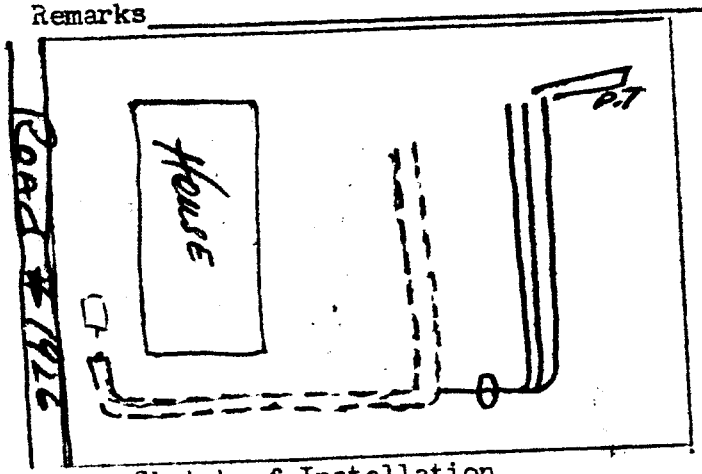

Sketch of Installation

Sanitarian