IREDELL COUNTY HEALTH DEPARTMENT

STATESVILLE 704-878-5305 MOORESVILLE 704-664-5281

IMPROVEMENT PERMIT / AUTHORIZATION TO CONSTRUCT / OPERATION PERMIT / EXISTING SYSTEM INSPECTION

PERMIT# 74742 PIN# 4736845756 DATE 7-9-98

OWNER OR CONTRACTOR G & G Building Mike Gaither PHONE: Business 7045465198 Home

ADDRESS 300 marshal

LOCATION Chipley Ford Rd TR Clearview 1mi left

SUBDIVISION willow brook BLOCK / SECTION LOT 11 LOT AREA 110'X170' SITE CLASS PS DESIGN FLOW 360 L.T.A.R. .73

Septic Tank: 1000 Gallons; STB 1012 Date 8-28-98

Pump Tank: Gallons; PT Date

Pump Make: Model Serial No.

Nitrification Field: No Fields 1 Square Feet 810 Linear Feet 270

No Lines 5 Trench Width 36" Max Trench Bottom Depth 36" Gravel Depth N/A

☑ New System ☐ Repair System Type: I, II, III, IV, V, VI

System Description: Gravity 25% Rdx

Repair System Description: Pump To 25% Rdx

Maintenance Agreement Required: ☐ Yes ☑ No

☐ House/Mod. Home ☐ Mobile Home ☐ Business ☐ Other

No. Bedrooms 3 No. Bathrooms 2 No. Employees


☐ Slab ☑ Crawl Space ☐ Basement w/plumbing ☐ Basement wo/plumbing

Water Supply: ☐ Individual ☑ Public ☐ Community

Comments:/Conditions:

Comments:/Conditions: 45 CHAMBERS INSTALLED FOR A TOTAL OF 278 LF

INITIAL SITE SKETCH

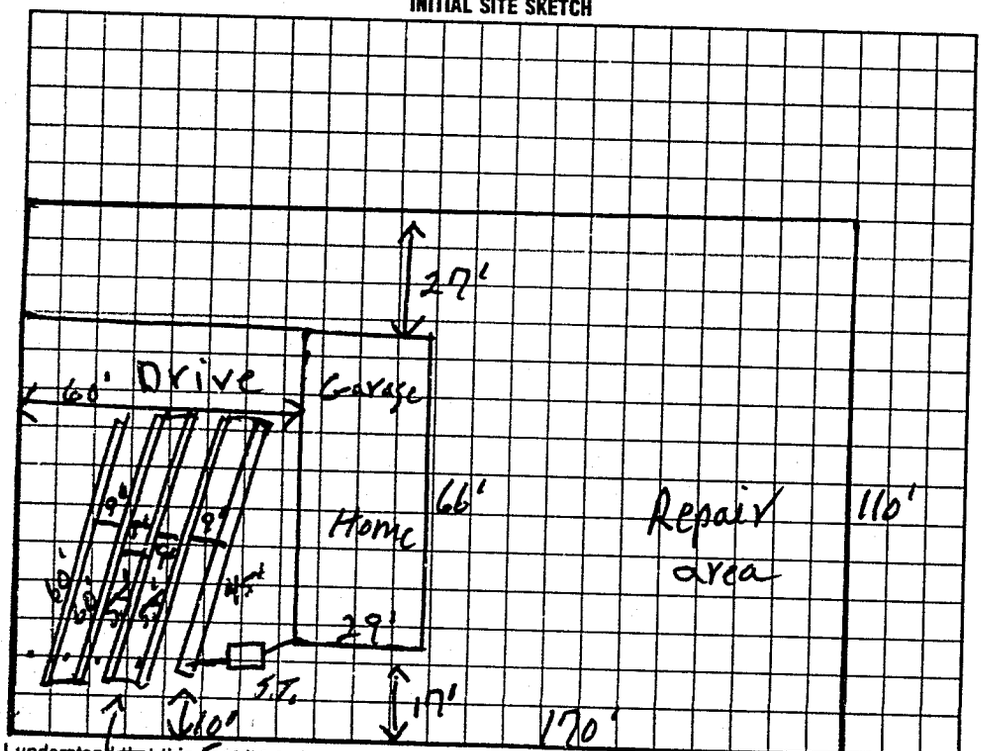

AS BUILT SKETCH

SYSTEM INSTALLED ACCORDING TO INITIAL SITE SKETCH

I understand that this permit can be suspended or revoked if any false information is supplied toward securing the permit/any unauthorized changes are made to the site/any unauthorized changes are made in the installation of the system. Improvement Permit with plat valid without expiration. Improvement Permit with site plan valid for sixty months. Authorization to Construct is valid for a period equal to that of Improvement Permit – not to exceed sixty months.

Signed: Mike Gaither date 7-13-98

Improvement Permit by: L. C. Moore date 7-9-98

Authorization to Construct by: L. C. Moore date 7-9-98

Installed by: Tommy Frye

Operation Permit by: Steve Hedrick date 10-27-98

Existing System Inspection by: date

HEALTH DEPT. COPY: WHITE INSPECTION COPY (FINAL): GREEN OWNER COPY (FINAL): YELLOW INSPECTION COPY (INITIAL): PINK OWNER COPY (INITIAL): GOLD