IREDELL COUNTY HEALTH DEPARTMENT

THIS PERMIT VOIDS PREVIOUS ISSUED 7-9-98

STATESVILLE 704-878-5305 MOORESVILLE 704-664-5281

IMPROVEMENT PERMIT / AUTHORIZATION TO CONSTRUCT / OPERATION PERMIT / EXISTING SYSTEM INSPECTION

PERMIT# 074741 PIN# 4736846764 DATE 10-27-98

OWNER OR CONTRACTOR G & G BUILDING PHONE: Business Home 546-5198

ADDRESS 300 MARSHALL FARM ROAD, HARMONY, NC 28634

LOCATION NC 115 N, TR S. CHIPLEY FORD, TR CLEARVIEW, 0.8 MILE ON LEFT

SUBDIVISION WILLOWBROOK BLOCK / SECTION LOT 10 LOT AREA 110 x 170 SITE CLASS. PS DESIGN FLOW 360 L.T.A.R. 0.33 GPD/FT²

Septic Tank: 1000 Gallons; STB 1012 Date 8-28-98
Pump Tank: Gallons; PT Date
Pump Make: Model Serial No.
Nitrification Field: No Fields 1 Square Feet REQ'D 1080 Linear Feet 2707
No Lines FIVE Trench Width 36" Max Trench Bottom Depth 36" Gravel Depth SAND 6"

☑ New System ☐ Repair System Type: I, II, III, IV, V, VI
System Description: 25% REDUCTION GRAVITY
Repair System Description: 25% REDUCTION PUMP
Maintenance Agreement Required: ☐ Yes ☑ No

☑ House/Mod. Home No. Bedrooms 3
☐ Mobile Home No. Bathrooms 2
☐ Business No. Employees
☐ Other

☐ Slab ☑ Crawl Space ☐ Basement w/plumbing ☐ Basement wo/plumbing


Water Supply: ☐ Individual ☑ Public ☐ Community

Comments:/Conditions: 45 CHAMBERS INSTALLED AT REQUEST

SCALE: 1" = 30'

Comments:/Conditions:

INITIAL SITE SKETCH

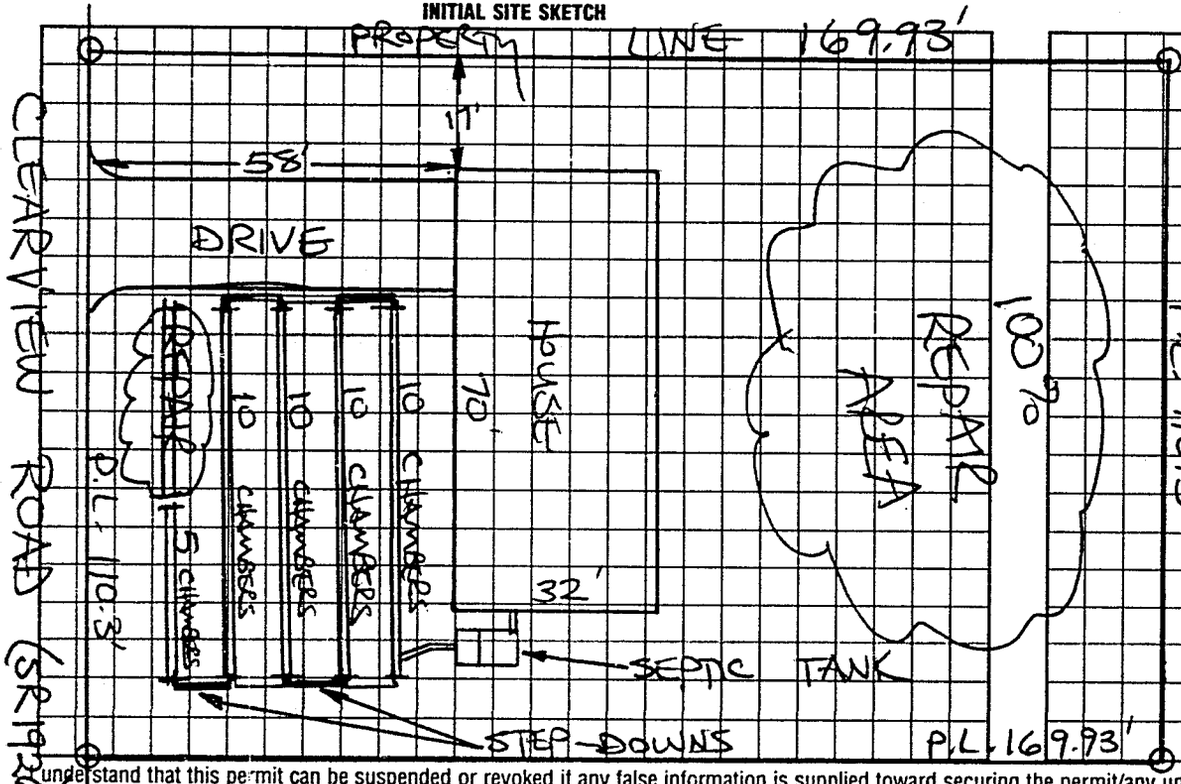

AS BUILT SKETCH

SYSTEM INSTALLED ACCORDING TO INITIAL SITE SKETCH

I understand that this permit can be suspended or revoked if any false information is supplied toward securing the permit/any unauthorized changes are made to the site/any unauthorized changes are made in the installation of the system. Improvement Permit with plat valid without expiration. Improvement Permit with site plan valid for sixty months. Authorization to Construct is valid for a period equal to that of Improvement Permit – not to exceed sixty months.

Signed: Michael L. Gaither date 11-6-98 Installed by: TOMMY FRYE

Improvement Permit by: STEVE HENDRICK date 10-27-98 Operation Permit by: STEVE HENDRICK date 10-27-98

Authorization to Construct by: STEVE HENDRICK date 10-27-98 Existing System Inspection by: date

HEALTH DEPT. COPY: WHITE INSPECTION COPY (FINAL): GREEN OWNER COPY (FINAL): YELLOW INSPECTION COPY (INITIAL): PINK OWNER COPY (INITIAL): GOLD

6 8 5 100