CI/CI

IREDELL COUNTY HEALTH DEPARTMENT

STATESVILLE 704-878-5305 MOORESVILLE 704-664-5281

IMPROVEMENT PERMIT / AUTHORIZATION TO CONSTRUCT / OPERATION PERMIT / EXISTING SYSTEM INSPECTION

PERMIT# 102064 PIN# 4736-84-6966 DATE 9-13-01

OWNER OR CONTRACTOR JACK BORDERS PHONE: Business Home 704-881-0025

ADDRESS 188 KNOX FARM RD STATESVILLE NC 28677

LOCATION 21N, (A) EDET DOBBS, (B) COOPER FARM RD, (C) CLEMVIEW, (D) ROCK ISLAND, 3RD ON RIGHT

SUBDIVISION WILLOW BROOK BLOCK / SECTION LOT 15 LOT AREA 1.457050 SITE CLASS PS DESIGN FLOW 360 L.T.A.R. 1.3

Septic Tank: 1000 Gallons: STB 1012 Date 9-06-02
Pump Tank: Gallons: PT Date
Pump Make: Model Serial No
Nitrification Field: No Fields 1 Square Feet 1200' Linear Feet 400'
No Lines 5 Trench Width 36" Max Trench Bottom Depth 36" Gravel Depth 12"

X New System Repair System Type: I II III IV V
System Description CONV GRAV
Repair System Description: LP PANEL
Maintenance Agreement Required Yes X No


X House/Mod Home No. Bedrooms 3
Mobile Home No. Bathrooms 2
Business No. Employees
Other
Slab X Crawl Space Basement w/plumbing Basement wo/plumbing

Water Supply: ☐ Individual X Public ☐ Community


Comments/Conditions: (1) INSTALL LINES ON CONTOUR (2) MAINTAIN SETBACKS (3) KEEP H2O LINE 10' FROM SYSTEM

Comments/Conditions: JUFFJITE FILLERS & MACKIE

INITIAL SITE SKETCH 1" = 50'

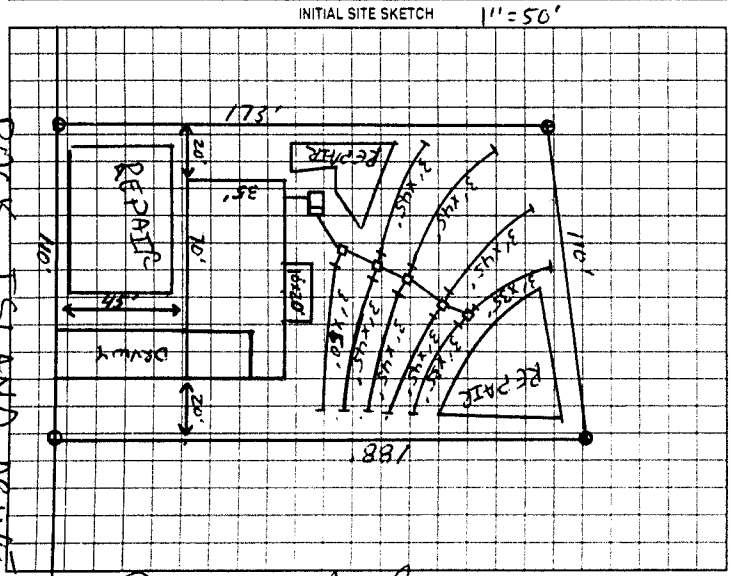

AS BUILT SKETCH

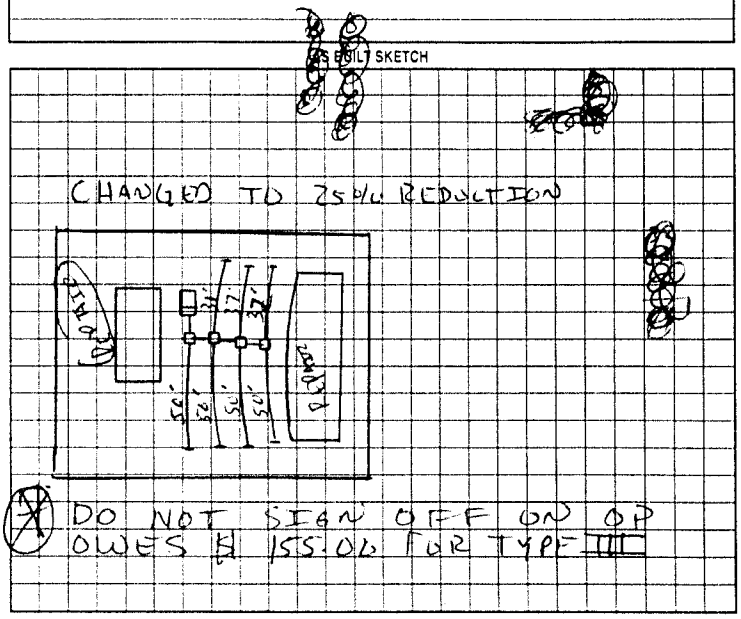

Permit can be suspended or revoked if any false information is supplied toward securing the permit, any unauthorized changes are made to the site, any unauthorized changes are made in the installation of the system. Improvement Permit with plat valid without expiration. Improvement Permit w/o site plan valid for sixty months. Authorization to Construct is valid for a period equal to that of Improvement Permit - not to exceed sixty months.

Signed: date

Improvement Permit by: date 9-13-01

Authorization to Construct by: date 9-13-01

Installed by DARE FOX

Operation Permit by date

Existing System Inspection by date

HEALTH DEPT COPY - WHITE OWNER COPY (FINAL) - YELLOW OWNER COPY (INITIAL) - PINK