TODD BENTLY

DIST BOX'S WITH SPEED LEVELER IN EACH BOX ON EACH LINE

IREDELL COUNTY HEALTH DEPARTMENT

STATESVILLE 704-878-5305 ✓

MOORESVILLE 704-664-5281

IMPROVEMENT PERMIT / AUTHORIZATION TO CONSTRUCT / OPERATION PERMIT / EXISTING SYSTEM INSPECTION

PERMIT# 102065 PIN# 4736-84-7974 DATE 8-8-01

OWNER OR CONTRACTOR JACK GOODERS PHONE: Business _____ Home 704-881-0025

ADDRESS 188 KNOX FARM RD STATESVILLE NC 28677

LOCATION HWY 21 N, (C) Ft. DOBBS RD, (E) COOPER FARM, (L) CLEARVIEW, (R) ROCK ISLAND RD, 5TH LOT ON RT

SUBDIVISION WILLOW BROOK BLOCK / SECTION _____ LOT 16 LOT AREA .420055 SITE CLASS PS DESIGN FLOW 360 L.T.A.R. 1.5

Septic Tank: 1000 Gallons: STB 1607 Date 11-2-01
Pump Tank: _____ Gallons: PT _____ Date _____
Pump Make: _____ Model _____ Serial No _____
Nitrification Field: No Fields 1 Square Feet 1200' Linear Feet 400'
No Lines 5 Trench Width 36" Max Trench Bottom Depth 36" Gravel Depth 12"

[X] New System [ ] Repair System Type: I, (II), III, IV, V, VI
System Description: CONV GRAV
Repair System Description: LP PANEL
Maintenance Agreement Required [ ] Yes [X] No


[X] House/Mod. Home No. Bedrooms 3
[ ] Mobile Home No. Bathrooms 2
[ ] Business No. Employees _____
[ ] Other _____

[ ] Slab [X] Crawl Space [ ] Basement w/plumbing [ ] Basement wo/plumbing

Water Supply: [ ] Individual [X] Public [ ] Community


Comments/Conditions: (1) USE DIST BOXES ON EACH LINE WITH SPEED LEVELERS TO INSURE RELEASE LOT IS SO FLAT (2) INSTALL LINES ON CONTOURS (3) MAINTAIN SETBACKS (4) NO GRADING OR FILLING OVER DRAINFIELD AREA

INITIAL SITE SKETCH

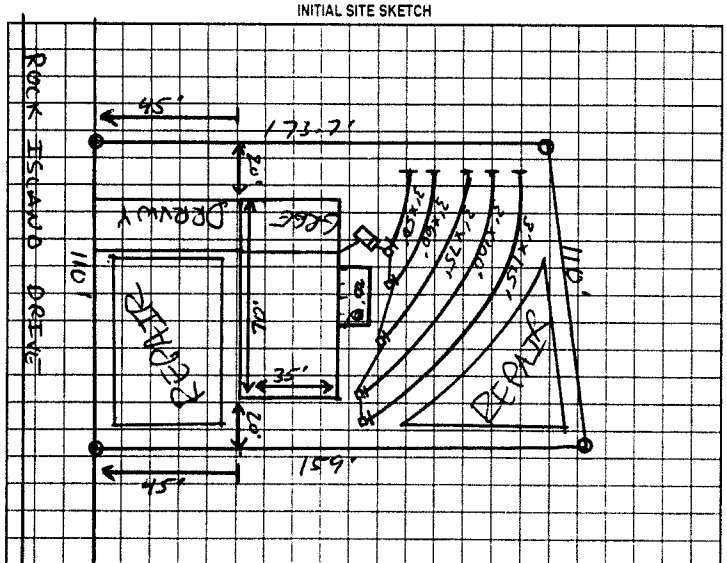

Comments/Conditions:
- Poly Lok Filter Installed
- Septic Tank Riser Installed
- Installed using drop boxes - Okay

AS BUILT SKETCH

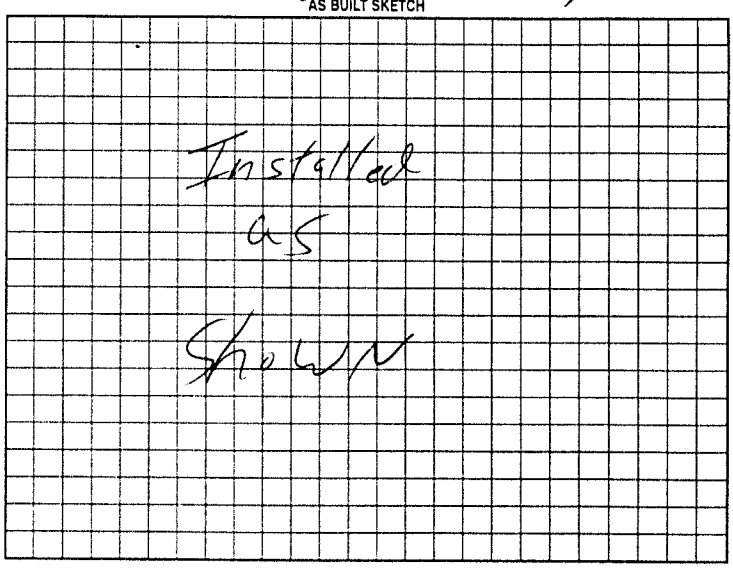

Permit can be suspended or revoked if any false information is supplied toward securing the permit, any unauthorized changes are made to the site, any unauthorized changes are made in the installation of the system. Improvement Permit with plat valid without expiration. Improvement Permit with site plan valid for sixty months. Authorization to Construct is valid for a period equal to that of Improvement Permit – not to exceed sixty months.

Signed: _____ date _____

Improvement Permit by: _____ RS date 9-8-01

Authorization to Construct by: _____ RS date 9-8-01

Installed by: Dale Fox Grading

Operation Permit by: William O. Johnson date 12/4/01

Existing System Inspection by: _____ date _____

HEALTH DEPT. COPY. WHITE OWNER COPY (FINAL). YELLOW OWNER COPY (INITIAL). PINK