IREDELL COUNTY HEALTH DEPARTMENT

Statesville Phone TR 3-7271 Mooresville Phone NO 3-1271

PERMIT TO INSTALL SEPTIC TANK

Permit NO. 1 E+ Bldgs Permit Date Sept 16 19 64

Owner Jack Johnson Address R8

Installed By C Hicks Address

Location of Property Out 115 N to 1907 - Chipley Ford Rd


~~Stat~~ R on 1926 - site on 1940 on R.

Tank		Capacity		Length of Lines		Fixtures	
Block	( )	800	( )	150'	( )	No. of Baths	(2)
Precast	(✓)	900	( )	175'	( )	Dishwasher	( )
		1000	(✓)	200'	( )	Garbage Grdr.	( )
		1100	( )	225'	(✓)	Auto-Washer	( )
		1200	( )	250'	( )	Other	
		Other		Other			

NOTIFY HEALTH DEPARTMENT AT LEAST EIGHT HOURS BEFORE TANK IS TO BE INSPECTED.

Final Inspection 9-16 19 64 Approved (✓) Disapproved ( )

Remarks GI # 3018-261 - DL108309 -

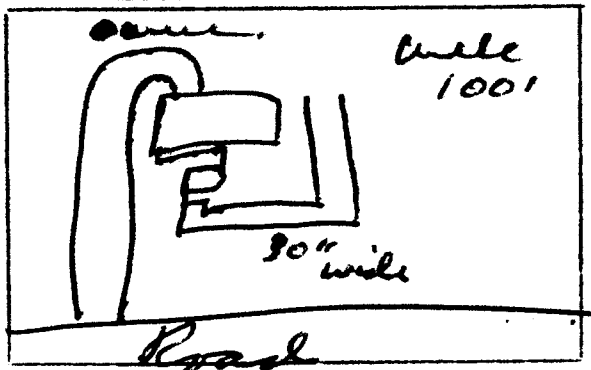

Sketch of Installation

Rut.

Sanitarian