IREDELL COUNTY HEALTH DEPARTMENT

STATESVILLE 704-878-5305 MOORESVILLE 704-664-5281

IMPROVEMENT PERMIT / AUTHORIZATION TO CONSTRUCT / OPERATION PERMIT / EXISTING SYSTEM INSPECTION

PERMIT# 90213 PIN# 4736847965 DATE 7-25-00

OWNER OR CONTRACTOR Jack Borders PHONE: Business 881 0025 Home

ADDRESS 188 Knox Farm Rd

LOCATION 115 N TR Chipley Ford TR Glenview TO Rock Island before entering Rt.

SUBDIVISION Willow Creek BLOCK / SECTION 2 LOT 18 LOT AREA 16541 SQ' SITE CLASS PS DESIGN FLOW 360 L.T.A.R. 125

Septic Tank: 1000 Gallons: STB 1012 Date 9-16-2000
Pump Tank: Gallons; PT Date
Pump Make: Model Serial No.
Nitrification Field: No Fields 1 Square Feet 1080 Linear Feet 360
No Lines 6 Trench Width 36" Max Trench Bottom Depth 36" Gravel Depth

☑ New System ☐ Repair System Type: I, II, III, IV, V, VI
System Description: Gravity 25% Reduct
Repair System Description: Pump To 25% Red
Maintenance Agreement Required: ☐ Yes ☐ No


☑ House/Mod. Home ☐ Mobile Home ☐ Business ☐ Other
No. Bedrooms 3 No. Bathrooms 2 No. Employees
☐ Slab ☑ Crawl Space ☐ Basement w/plumbing ☐ Basement wo/plumbing

Water Supply: ☐ Individual ☑ Public ☐ Community

Comments/Conditions:

Comments/Conditions INSTALLED WITH POLYLOK FILTER SOCKS
RISERS
INSTALLED AS SHOWN

INITIAL SITE SKETCH

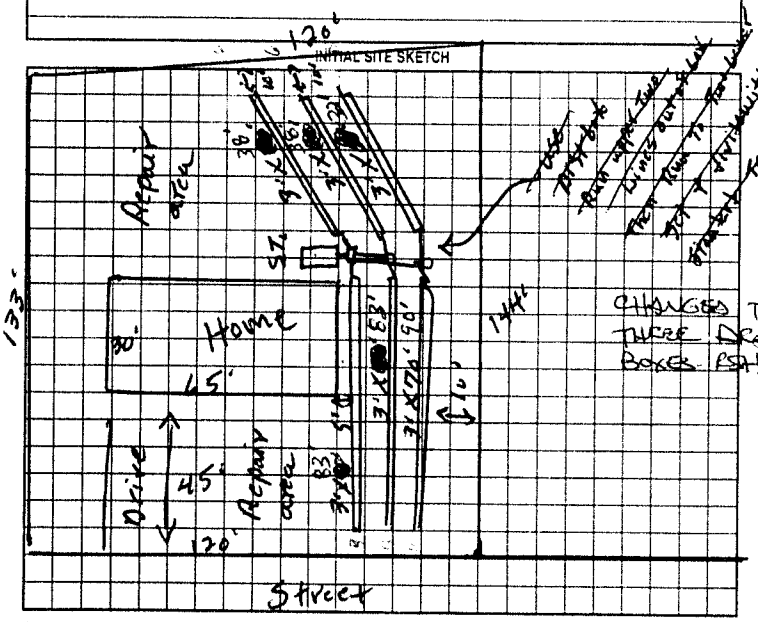

AS BUILT SKETCH

Permit can be suspended or revoked if any false information is supplied toward securing the permit/any unauthorized changes are made to the site/any unauthorized changes are made in the installation of the system. Improvement Permit with plat valid without expiration. Improvement Permit with site plan valid for sixty months. Authorization to Construct is valid for a period equal to that of Improvement Permit – not to exceed sixty months.

Signed: date 8-9-2000 Installed by: DALE FOX

Improvement Permit by: R.C. Moore date 7-25-00 Operation Permit by: Steve Cook RSI date 02.02.01

Authorization to Construct by: R.C. Moore date 7-25-00 Existing System Inspection by: date

HEALTH DEPT COPY WHITE OWNER COPY (FINAL) YELLOW OWNER COPY (INITIAL) PINK