IREDELL COUNTY HEALTH DEPARTMENT

STATESVILLE 704-878-5305 MOORESVILLE 704-664-5281

IMPROVEMENT PERMIT / AUTHORIZATION TO CONSTRUCT / OPERATION PERMIT / EXISTING SYSTEM INSPECTION

PERMIT# 094610 PIN# 4736858193 DATE 3/2/01

OWNER OR CONTRACTOR Jack Gardners PHONE: Business (704) 881-0025 Home —

ADDRESS 188 Knox Farm Rd Statesville N.C. 28677

LOCATION 2 N. (2) on Fort Dobbs, (1) on Cooper Farm (3) Clearview (R) on Rock Island Dr. on Left

SUBDIVISION Willow Brook BLOCK / SECTION 2 LOT 25 LOT AREA .43 Acres SITE CLASS P5 DESIGN FLOW 360 L.T.A.R. .3

Septic Tank: 4000 Gallons: STB 1007 Date 5-5-01

Pump Tank: — Gallons: PT — Date —

Pump Make: — Model — Serial No —

Nitrification Field: No Fields 1 Square Feet ~~1,200~~ 1,200 Linear Feet 300

No Lines 6 @ 50' Trench Width 36" Max Trench Bottom Depth 30" Gravel Depth —

[X] New System [ ] Repair System Type: I, II, [III], IV, V, VI

System Description: Gravity, 25% Reduction

Repair System Description: Pump, 50% Reduction

Maintenance Agreement Required: [ ] Yes [X] No

[X] House/Mod. Home [ ] Mobile Home [ ] Business [ ] Other

No. Bedrooms 3 No. Bathrooms 2 No. Employees —


[ ] Slab [X] Crawl Space [ ] Basement w/plumbing [ ] Basement wo/plumbing

Water Supply: [ ] Individual [X] Public [ ] Community


Comments/Conditions: 10% Not in Stall when built (2) Install 25% Reduction System- Chambers or HDPE Section (3) Use One (1) Flow divider & Two (2) distribution boxes

Comments/Conditions — Installed 50 Infiltrators Chambers

INITIAL SITE SKETCH

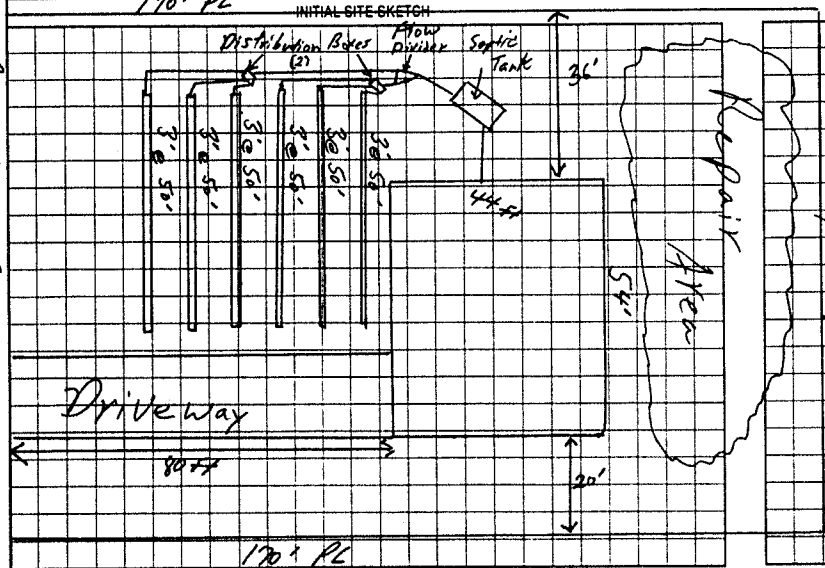

AS BUILT SKETCH

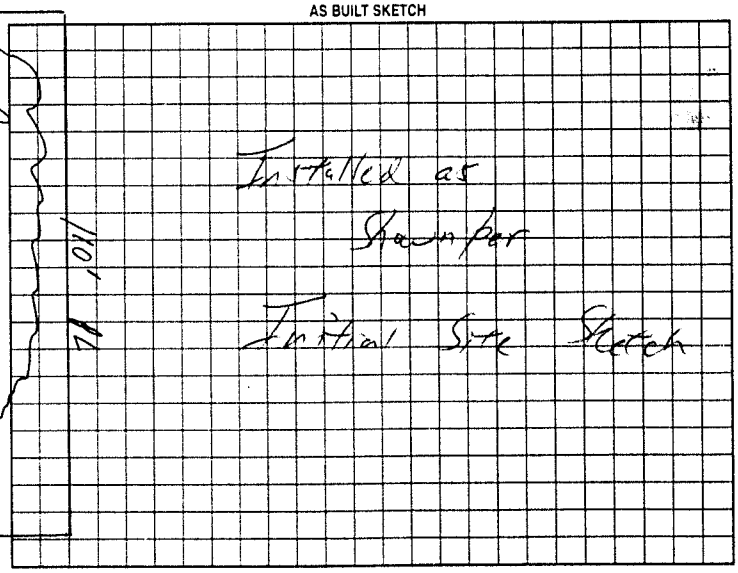

Rock Island Drive

Permit can be suspended or revoked if any false information is supplied toward securing the permit/any unauthorized changes are made to the site/any unauthorized changes are made in the installation of the system. Improvement Permit with plat valid without expiration. Improvement Permit with site plan valid for sixty months. Authorization to Construct is valid for a period equal to that of Improvement Permit – not to exceed sixty months.

Signed: [signature] date —

Improvement Permit by: William O. Johnson RSI date 3/2/01

Authorization to Construct by: William O. Johnson RSI date 3/2/01

Installed by: Dale Fox Grading Inc.

Operation Permit by: William O. Johnson date 8/29/01

Existing System Inspection by: — date —

HEALTH DEPT COPY WHITE OWNER COPY (FINAL) YELLOW OWNER COPY (INITIAL) PINK