IREDELL COUNTY HEALTH DEPARTMENT

STATESVILLE 704-878-5305 MOORESVILLE 704-664-5281

IMPROVEMENT PERMIT / AUTHORIZATION TO CONSTRUCT / OPERATION PERMIT / EXISTING SYSTEM INSPECTION

DATE 5/4/01

PERMIT# 092668 PIN# 4736 86 2398 PHONE: Business — Home (704) 876-3228

OWNER OR CONTRACTOR Jeffery Lippard Statesville N.C. 28625

ADDRESS 151 Lippard Hill Lane

LOCATION 115 N @ S. Chipley Ford @ Nixon 1st on Lippard Hill Lane

SUBDIVISION — BLOCK / SECTION — LOT 1 LOT AREA .5 Ac. SITE CLASS P5 DESIGN FLOW 360 L.T.A.R. .35

Septic Tank: 1000 Gallons: ~~STB~~ — Date —

Pump Tank: — Gallons: PT — Date —

Pump Make: — Model — Serial No. ~~Exist~~ —

Nitrification Field: No Fields 1 Square Feet 720 Linear Feet ~~Exist~~ 240

No Lines 3 Trench Width — Max Trench Bottom Depth —

☐ New System ☐ Repair System Type: I II III IV V VI

System Description: ~~Existing~~ Gravity, Conventional

Repair System Description: —

Maintenance Agreement Required: ☐ Yes ☒ No

Gravel Depth 12" ☐ Slab ☐ Crawl Space ☐ Basement w/plumbing ☐ Basement wo/plumbing

☒ House/Mod. Home ☐ Mobile Home ☐ Business ☐ Other

No. Bedrooms 3 No. Bathrooms 2 No. Employees —

Water Supply: ☒ Individual ☐ Public ☐ Community


Comments/Conditions:

Comments/Conditions: (Ref: Jeff Lippard 7-28-88)

- Existing System Lookey Property
- Req 3 Bed House 5ST Trad System

INITIAL SITE SKETCH

AS BUILT SKETCH

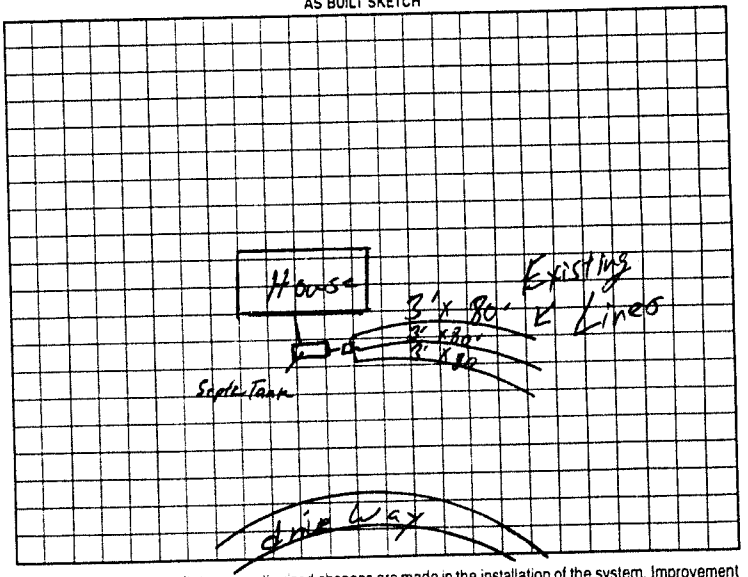

Permit can be suspended or revoked if any false information is supplied toward securing the permit/any unauthorized changes are made to the site/any unauthorized changes are made in the installation of the system. Improvement Permit with plat valid without expiration. Improvement Permit with site plan valid for sixty months. Authorization to Construct is valid for a period equal to that of Improvement Permit – not to exceed sixty months.

Signed: x Jeff D Lippard date 5/4/01

Improvement Permit by: — date —

Authorization to Construct by: — date —

Installed by: —

Operation Permit by: — date —

Existing System Inspection by: William G Johnson REHS date 5/4/01

HEALTH DEPT COPY: WHITE OWNER COPY (FINAL): YELLOW OWNER COPY (INITIAL): PINK