This permit voids previously issued permit dated 8/30/02.

IREDELL COUNTY HEALTH DEPARTMENT

STATESVILLE 704-878-5305 ~~fax~~ CI MOORESVILLE 704-664-5281

IMPROVEMENT PERMIT / AUTHORIZATION TO CONSTRUCT / OPERATION PERMIT / EXISTING SYSTEM INSPECTION

PERMIT# 107 612 PIN# ~~4736-90-1277.8~~ 4736-96-0348 DATE 3-6-02

OWNER OR CONTRACTOR K. W. Nicholson PHONE: Business Home (704 878-2517

ADDRESS 930 Argyle Court Statesville N.C. 28677

LOCATION 21 N @ Fort Dobbs, @ Natures Trail on right

SUBDIVISION Dobbs Valley BLOCK / SECTION LOT 8 LOT AREA 2.154 SITE CLASS. P5 DESIGN FLOW 360 L.T.A.R. .25 gpd/ft²

Septic Tank: 4,000 Gallons; STB 1012 Date 1-20-03
Pump Tank: 4,000 Gallons; PT 17 Date 4-14-03
Pump Make: Goulds Model WE05/2HHU Serial No. F0356317
Nitrification Field: No Fields 1 Square Feet 1440 Linear Feet 480
No Lines 5@96' Trench Width 36" Max Trench Bottom Depth 24" Gravel Depth 12"


☒ New System ☐ Repair System Type: I, II, (III) IV, V, VI
System Description: Pump, Conventional
Repair System Description: Pump, Panel
Maintenance Agreement Required: ☐ Yes ☒ No

☒ House/Mod. Home No. Bedrooms 3
☐ Mobile Home No. Bathrooms 2½
☐ Business No. Employees
☐ Other
☐ Slab ☒ Crawl Space ☐ Basement w/plumbing ☐ Basement wo/plumbing

Water Supply: ☒ Individual ☒ Public ☐ Community


Comments/Conditions: ① Install liner on contour @ contact Health Dept for Pump Sizing

INITIAL SITE SKETCH

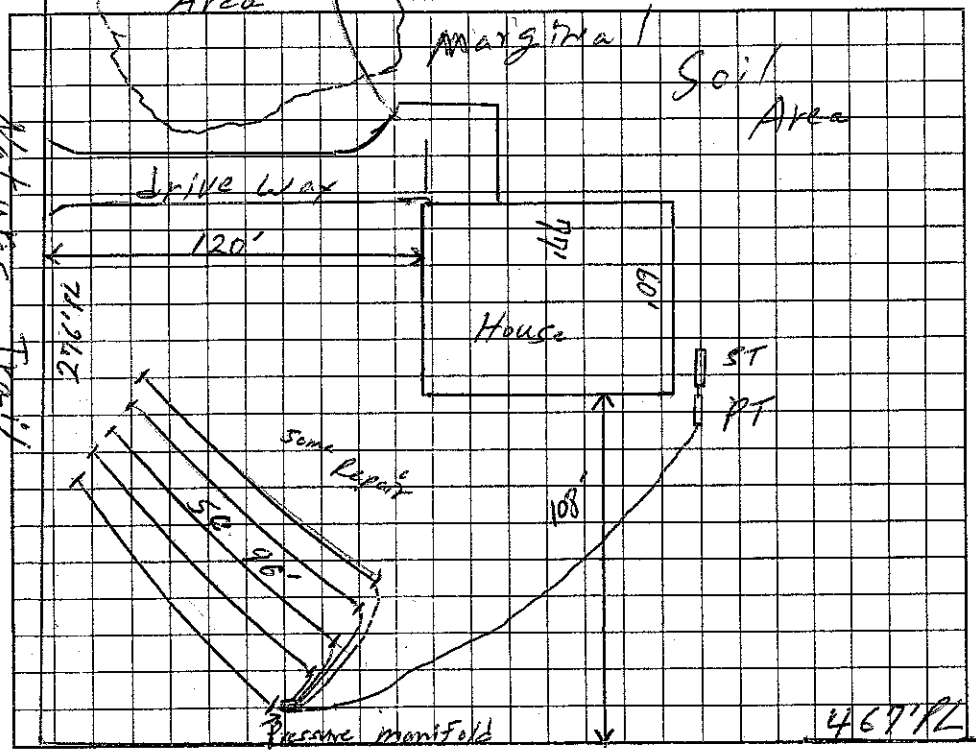

Comments/Conditions: 400' RL – Tuff-Tite filter + ST bracket
Lines checked 8/22 okay w/ Installer
– Pressure check, Float tree,
Electrical + Alarm – Okay
9/24/03 – Cmp

AS BUILT SKETCH

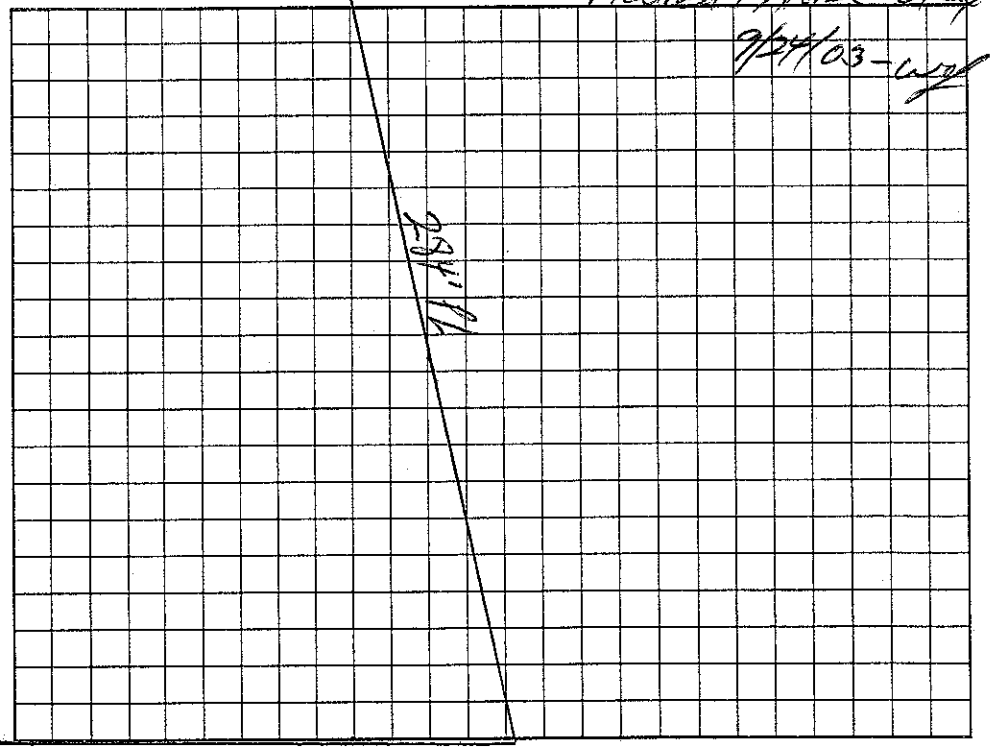

Permit can be suspended or revoked if any false information is supplied toward securing the permit/any unauthorized changes are made to the site/any unauthorized changes are made in the installation of the system. Improvement Permit with plat valid without expiration. Improvement Permit with site plan valid for sixty months. Authorization to Construct is valid for a period equal to that of Improvement Permit – not to exceed sixty months.

Signed: [signature] date 3-7-03 Installed by: David Young

Improvement Permit by: William O. Johnson date 3-6-02 Operation Permit by: William O. Johnson date 9/24/03

Authorization to Construct by: William O. Johnson date 3-6-02 Existing System Inspection by: date

HEALTH DEPT. COPY: WHITE OWNER COPY (FINAL): YELLOW OWNER COPY (INITIAL): PINK