# IREDELL COUNTY HEALTH DEPARTMENT

STATESVILLE 704-878-5305 CI MOORESVILLE 704-664-5281

## IMPROVEMENT PERMIT / AUTHORIZATION TO CONSTRUCT / OPERATION PERMIT / EXISTING SYSTEM INSPECTION

PERMIT# 107611 PIN# 4736-90-1117 DATE 8-3-06

OWNER OR APPLICANT 6 REE BUILDERS PHONE: Business 704-662-5177 Home

ADDRESS 454 COOPER FARM RD STATESVILLE NC 28625

LOCATION 21 N TO H DOBBS R NANCES TRAIL DR RT LOT # 7

SUBDIVISION DOBBS VALLEY BLOCK / SECTION LOT 7 LOT AREA 1.96 AC SITE CLASS. B DESIGN FLOW 360 L.T.A.R. .3

Septic Tank: 1000 Gallons; STB 1017 Date 1-14-05
Pump Tank: 1000 Gallons; PT 17 Date 5-15-06
Pump Make: CAMUS 1/2 HP Model WED5121-U Serial No. E0C800445
Nitrification Field: No Fields 1 Square Feet 576=12a' Linear Feet 300
No Lines 3 @ 100 Trench Width 36" Max Trench Bottom Depth 36" Gravel Depth N/A ☐ Gravity ☑ Pressure ☐ Slab ☐ Crawl Space ☑ Basement w/plumbing ☐ Basement wo/plumbing

☑ New System ☐ Repair ☐ Expansion System Type: I II III IV V VI
System Description: PUMP 25% REDUCT
Repair System Description: LP 25% REDUCT
Maintenance Agreement Required: ☐ Yes ☒ No


☑ House/Mod. Home No. Bedrooms 3
☐ Mobile Home No. Persons 6
☐ Business No. Employees
☐ Other

Water Supply: ☐ Individual ☒ Public ☐ Community


Comments:/Conditions: ① THIS PERMIT IS A REDRAW AND PREVIOUS SOIL WORK WAS PERFORMED BY B. FREEMAN PROGRAM SPECIALIST.
② INSTALL LEVELS ON CONTOURS UNDISTURBED SETBACKS

Comments:/Conditions:

INITIAL SITE SKETCH 1" = 50'

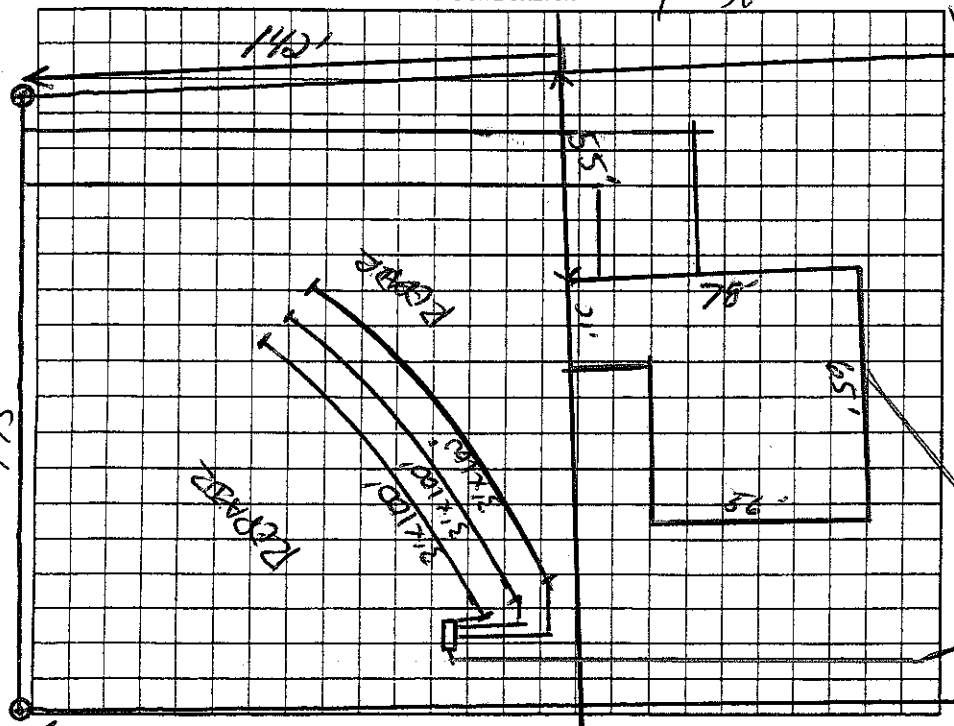


AS BUILT SKETCH

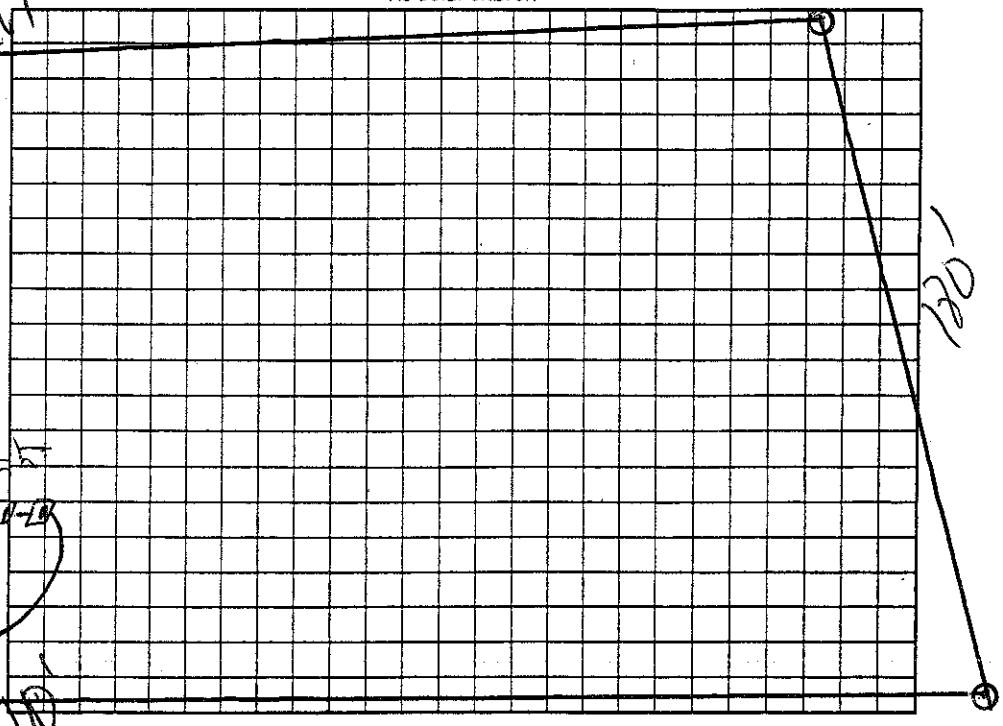


Permit can be suspended or revoked if any false information is supplied toward securing the permit/any unauthorized changes are made to the site/any unauthorized changes are made in the installation of the system. Improvement Permit with plat valid without expiration ☐ Improvement Permit with site plan valid for sixty months ☑ Authorization to Construct is valid for a period equal to that of Improvement Permit – not to exceed sixty months.

Signed: date 8-8-06 Installed by: Steve Jordan

Improvement Permit by: date 8-8-06 Operation Permit by: date 9/20/06

Authorization to Construct by: date 8-8-06 Existing System Inspection by: date

HEALTH DEPT. COPY: WHITE OWNER COPY (FINAL): YELLOW OWNER COPY (INITIAL): PINK