THIS PERMIT VOIDS EXPIRED PERMIT ISSUED 8-27-97

IREDELL COUNTY HEALTH DEPARTMENT

STATESVILLE 704-878-5305 (C1) MOORESVILLE 704-664-5281 #69058

(C1) IMPROVEMENT PERMIT / AUTHORIZATION TO CONSTRUCT / OPERATION PERMIT / EXISTING SYSTEM INSPECTION

PERMIT# 109566 PIN# 4736-92-4765 DATE 10-31-02

OWNER OR CONTRACTOR J. TODD ELLIS PHONE: Business 704-902-0119 Home

ADDRESS COOPER FARM ROAD, STATESVILLE, NC 28625

LOCATION US 21 N, TL FORT DOBBS RD, TR COOPER FARM ROAD, 0.7 MILE ON LEFT

SUBDIVISION BLOCK / SECTION LOT LOT AREA 10 ACRES SITE CLASS. 1 PS DESIGN FLOW 460 L.T.A.R. 0.25GPD/FT²

Septic Tank: 1000 Gallons; STB 1012 Date 12-16-03
Pump Tank: Gallons; PT Date
Pump Make: Model Serial No.
Nitrification Field: No Fields 1 Square Feet 1840 Linear Feet 615
No Lines FIVE Trench Width 36" Max Trench Bottom Depth 36" Gravel Depth 12"

☑ New System ☐ Repair System Type: I, II, III, IV, V, VI
System Description: CONVENTIONAL, GRAVITY
Repair System Description: CONVENTIONAL, GRAVITY
Maintenance Agreement Required: ☐ Yes ☑ No


☑ House/Mod. Home ☐ Mobile Home ☐ Business ☐ Other PLUS OFFICE
No. Bedrooms 3 No. Bathrooms 4 No. Employees
☐ Slab ☑ Crawl Space ☐ Basement w/plumbing ☐ Basement wo/plumbing

Water Supply: ☑ Individual ☐ Public ☐ Community WELL


Comments/Conditions: (1) SCOUR TRENCH SIDEWALLS WHERE SMEARING OCCURS & APPLY A LIGHT DUSTING OF LIME PRIOR TO INSTALLING STONE (2) KEEP SYSTEM MINIMUM 100 FEET FROM WELL

Comments/Conditions: SEPTIC TANK WITH MARKER INSTALLED USING "TUFTITE" FILTER

INITIAL SITE SKETCH

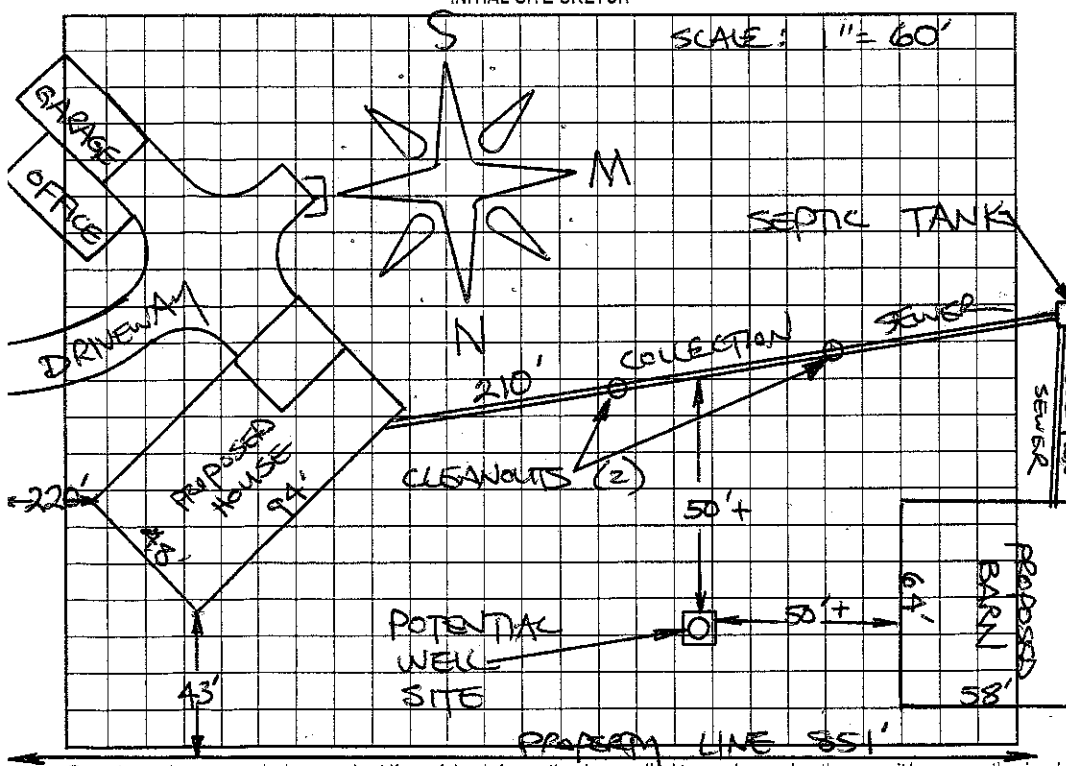

AS BUILT SKETCH

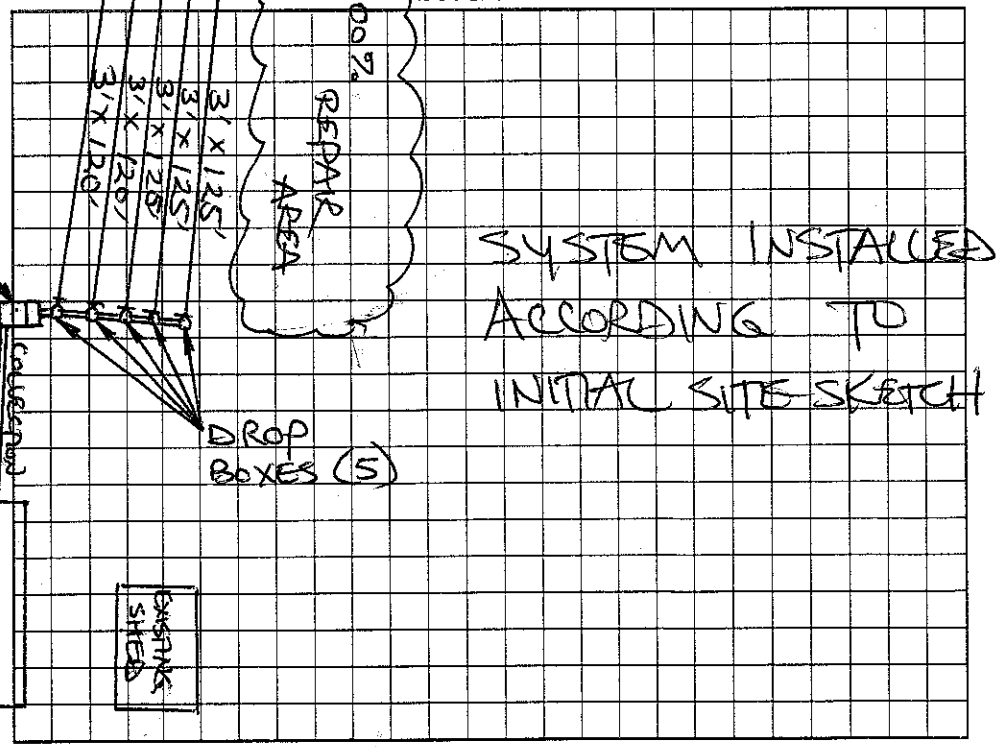

Permit can be suspended or revoked if any false information is supplied toward securing the permit/any unauthorized changes are made to the site/any unauthorized changes are made in the installation of the system. Improvement Permit with plat valid without expiration. Improvement Permit with site plan valid for sixty months. Authorization to Construct is valid for a period equal to that of Improvement Permit – not to exceed sixty months.

Signed: J Todd Ellis date 10-31-02 Installed by: DAVID YOUNTZ

Improvement Permit by: STEVE HEDRICK date 10-31-02 Operation Permit by: STEVE HEDRICK date 5-28-04

Authorization to Construct by: STEVE HEDRICK date 10-31-02 Existing System Inspection by: date

HEALTH DEPT. COPY: WHITE OWNER COPY (FINAL): YELLOW OWNER COPY (INITIAL): PINK