IREDELL COUNTY HEALTH DEPARTMENT

Statesville Phone TR 3-7271 Mooresville Phone NO 3-1271

PERMIT TO INSTALL SEPTIC TANK

Permit NO. 91 Permit Date 8-23 1972

Owner Donald Simonton Address Statesville, N.C.

Installed By LACKEY Bros. Address Stony Point, N.C.


Location of Property 21 N. - Turn LEFT on Rd # 1930 (Ft Dobbs Rd) Then Right on Rd # 1925 - Go 3/4 Mile Trailer on LEFT.

Tank		Capacity		Length of Lines		Fixtures	
Block	( )	1000	(✓)	225'	(✓)	No. of Baths	(1)
Precast	(✓)	1250	( )	250'	( )	Dishwasher	( )
		1500	( )	Other		Garbage Grdr.	( )
		Other				Other	

NOTIFY HEALTH DEPARTMENT AT LEAST EIGHT HOURS BEFORE TANK IS TO BE INSPECTED.

Final Inspection 8-23 1972 Approved (✓) Disapproved ( )

Remarks WATER SUPPLY from well Simonton house -

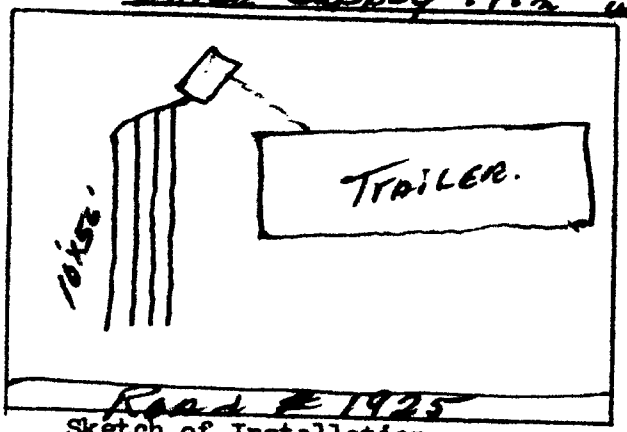

Sketch of Installation

Glenn Fox

Sanitarian