IREDELL COUNTY HEALTH DEPARTMENT

Statesville Phone TR 3-7271 Mooresville Phone NO 3-1271

PERMIT TO INSTALL SEPTIC TANK

Permit NO._____ Permit Date 8 22 1963

Owner D. D. WALKER Address RED STR.

Installed By OSTWALT Address TRENTMAN


Location of Property ONT CHIPLEY FORD RD CROSS 2nd BRIDGE 1st road Right 1st Developmt - 2nd Right

Tank		Capacity		Length of Lines		Fixtures	
Block	(✓)	800	( )	150'	( )	No. of Baths	(✓) 2½
Precast	( )	900	( )	175'	( )	Dishwasher	( )
		1000	( )	200'	( )	Garbage Grdr.	( )
		1100	(✓)	225'	(✓)	Auto-Washer	( )
		1200	( )	250'	( )	Other_____	
		Other_____		Other_____			

NOTIFY HEALTH DEPARTMENT AT LEAST EIGHT HOURS BEFORE TANK IS TO BE INSPECTED.

Final Inspection 8-22 1963 Approved (✓) Disapproved ( )

Remarks_____

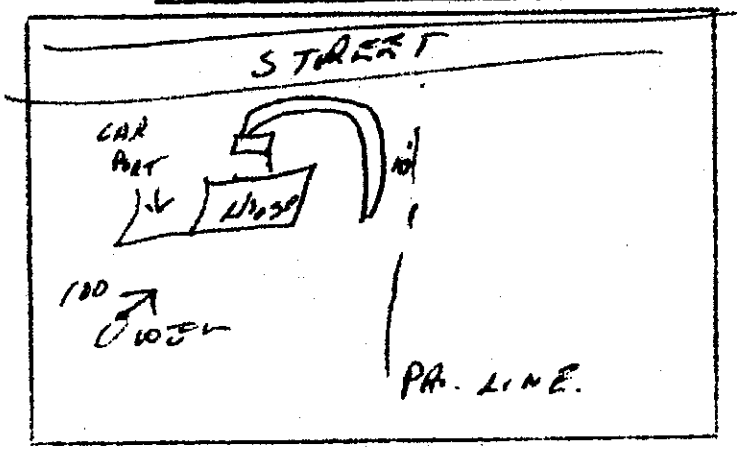

Sketch of Installation

The house and septic are reversed in this site sketch image

Raymond A. Johnson

Sanitarian