IREDELL COUNTY HEALTH DEPARTMENT

STATESVILLE 704-878-5305 MOORESVILLE 704-664-5281

IMPROVEMENT PERMIT / AUTHORIZATION TO CONSTRUCT / OPERATION PERMIT / EXISTING SYSTEM INSPECTION

PERMIT# 90214 PIN# 4736847965 DATE 7-25-00

OWNER OR CONTRACTOR Jack Borders PHONE: Business 881 0025 Home

ADDRESS 188 Knox Farm Rd Statesville, N.C. 28677

LOCATION 115W TR Chipley Ford TR Clearview TL Rock Island Tower ent on Rt.

SUBDIVISION Willowbrook BLOCK / SECTION 2 LOT 19 LOT AREA 17216 SITE CLASS PS DESIGN FLOW 360 L.T.A.R. 1.3

Septic Tank: 1000 Gallons; STB 1012 Date 4-22-41
Pump Tank: Gallons; PT Date
Pump Make: Model Serial No.
Nitrification Field: No Fields 1 Square Feet 900 Linear Feet 300
No Lines 4 Trench Width 36" Max Trench Bottom Depth 36" Gravel Depth N/A

☑ New System ☐ Repair System Type: I II III IV V VI
System Description: Gravity 25% Reduction
Repair System Description:
Maintenance Agreement Required: ☐ Yes ☑ No


☑ House/Mod. Home No. Bedrooms 3
☐ Mobile Home No. Bathrooms 2
☐ Business No. Employees
☐ Other
☐ Slab ☑ Crawl Space ☐ Basement w/plumbing ☐ Basement wo/plumbing

Water Supply: ☐ Individual ☑ Public ☐ Community


Comments:/Conditions:

Comments:/Conditions:
- 6" Loft Filter Installed
- Infiltrator Chambers Installed w/sand
- Top Line Chambers (55" deep)
- Septic Tank Marker Installed

INITIAL SITE SKETCH

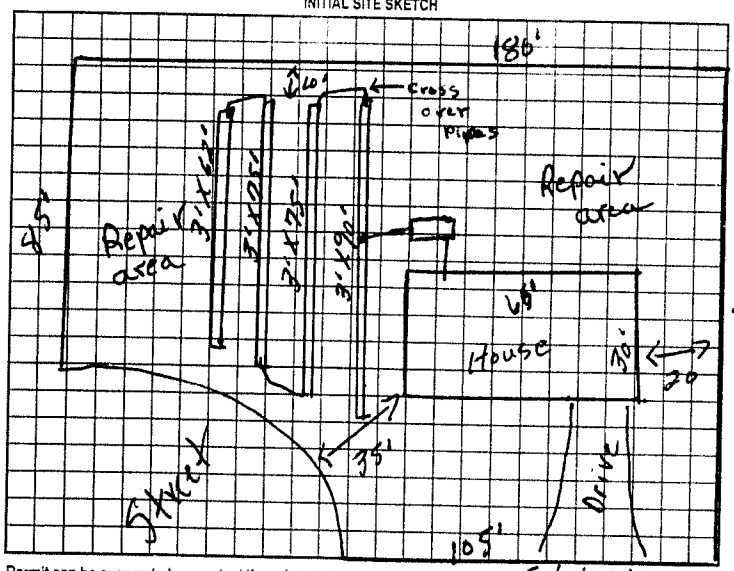

AS BUILT SKETCH

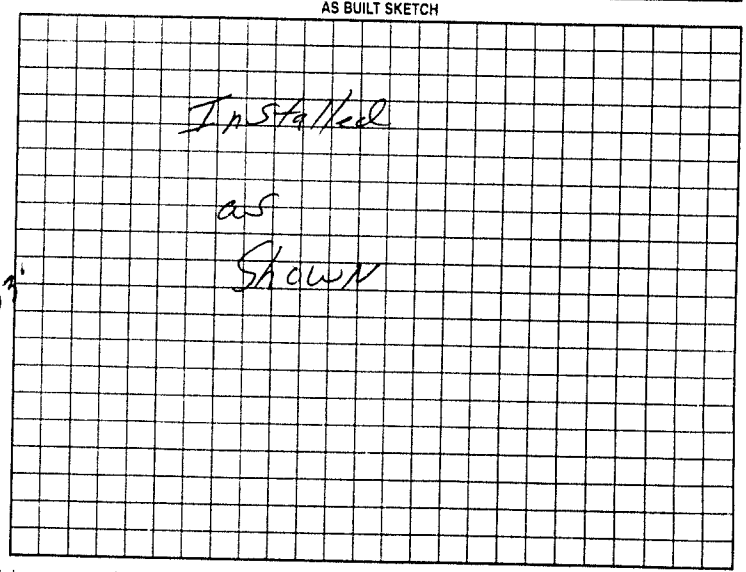

Permit can be suspended or revoked if any false information is supplied toward securing the permit/any unauthorized changes are made to the site/any unauthorized changes are made in the installation of the system. Improvement Permit with plat valid without expiration. Improvement Permit with site plan valid for sixty months. Authorization to Construct is valid for a period equal to that of Improvement Permit – not to exceed sixty months.

Signed: [signature] date 8-9-2000 Installed by: Dale Fox

Improvement Permit by: P.C. Moore date 7-25-00 Operation Permit by: [signature] date 7/14/01

Authorization to Construct by: P.C. Moore date 7-25-00 Existing System Inspection by: date

HEALTH DEPT. COPY: WHITE OWNER COPY (FINAL): YELLOW OWNER COPY (INITIAL): PINK