IREDELL COUNTY HEALTH DEPARTMENT

STATESVILLE 704-878-5305 MOORESVILLE 704-664-5281

IMPROVEMENT PERMIT / CERTIFICATE OF COMPLETION / OPERATION PERMIT / EXISTING SYSTEM INSPECTION

PROPERTY DESCRIPTION NO. 70355 DATE 11-13-97 TAX MAP NO. 4736942772

OWNER OR CONTRACTOR Jack Bortes PHONE: Business Watershed: ☐ Yes ☐ No

ADDRESS 188 Knox Fm Rd Home 881-0025

LOCATION 2 IN TL Shoemakers TL Nixon TL Cooper Fm Rd TR clearview 2nd lot on rt

SUBDIVISION Willowbrook BLOCK / SECTION LOT 5 LOT AREA .43 acres SITE CLASS PS DESIGN FLOW 360 L.T.A. 133

Septic Tank: 1000 Gallons; STB 1012 Date 6-15-98

Pump Tank: Gallons; PT Date

Pump Make: Model Serial No.

Nitrification Field: No Fields 1 Square Feet 1080 Linear Feet 360

No Lines 5 Trench Width 36" Max Trench Bottom Depth 36" Gravel Depth 12"

☐ New System ☐ Repair System Type: I, II, III, IV, V, VI

System Description: Conv. Gravity

Repair System Description: Gravity Chambers

Maintenance Agreement Required: ☐ Yes ☐ No

☑ House/Mod. Home No. Bedrooms 3

☐ Mobile Home No. Bathrooms 2

☐ Business No. Employees


☐ Other

☐ Slab ☑ Crawl Space ☐ Basement w/plumbing ☐ Basement wo/plumbing

Water Supply: ☐ Individual ☐ Community ☑ Public

Comments:

INITIAL SITE SKETCH

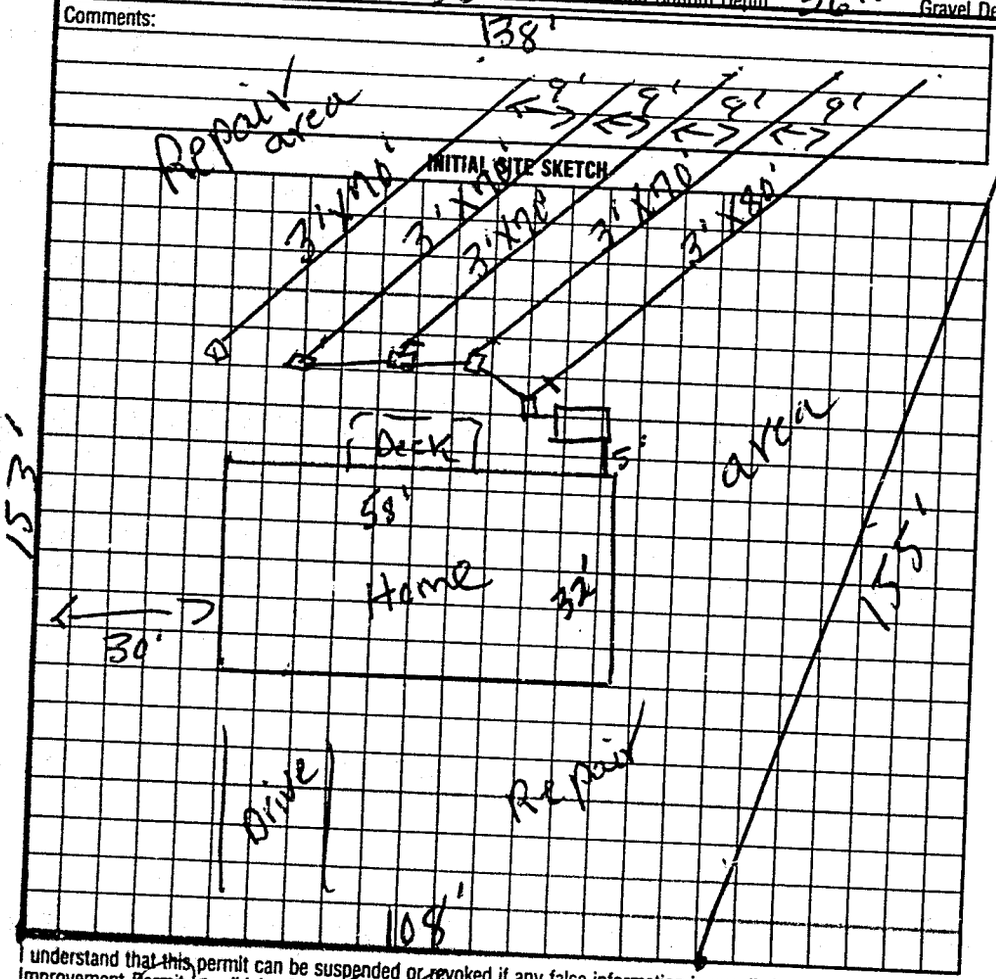

Comments:

AS BUILT SKETCH

Installed as shown

I understand that this permit can be suspended or revoked if any false information is supplied toward securing the permit/any unauthorized changes are made to the site/any unauthorized changes are made in the installation of the system. Improvement Permit is valid for 60 months from date of issuance.

Signed:

Improvement Permit by: R.C. Moore date 11-13-97

Authorization to Cover

Existing System Inspection by: R.C. Moore date 11-13-97

Installed by: Dale Fox

Certificate of Completion by: date

Operation Permit by: Mat C Ott RS date 5-21-98

HEALTH DEPT. COPY: WHITE INSPECTION COPY (FINAL): GREEN OWNER COPY (FINAL): YELLOW INSPECTION COPY (INITIAL): PINK OWNER COPY (INITIAL): GOLD

Authorization to Cover Expires 60 mos from issue.